


21606040020

U. S. PUBLIC LAND SURVEY MONUMENT RECORD

SECTION 4 T 16 N, R 6 W, TOWN OF HAMILTON

LA CROSSE COUNTY

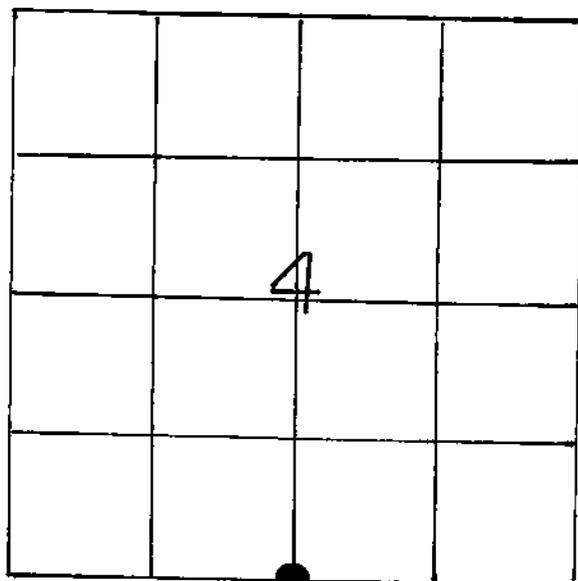

LOCATION OF LANDMARK

WISCONSIN COORDINATE SYSTEM

North

East

Theta Angle

Horiz. Order

Vert. Order

TYPE OF LANDMARK

P.K. nail

BEARINGS ARE REFERENCED TO

Assumed

Crew: William C. Jung
Peter F. Follansbee

Date: August 6, 1991

Describe any record evidence, monument evidence, testimonial evidence or any other material evidence you considered and whether the monument was found or restored through acceptance of an obliterated evidence location.

The old corner was destroyed during road construction. The new corner is monumented with a P.K. nail.


(See my 1986 tie sheet for a narrative of the corner.)

Describe or show any material discrepancy between the location of the restored corner and that of the corner previously restored or reestablished.

None known.


RECORD OF DURABLE WITNESS MONUMENTS

NO	DESCRIPTION	BEARING	DISTANCE
1	Existing iron bar	-----	80.56
2	P.K. nail in power pole	-----	57.93
3	To the center of a vent pipe (@ the bottom)	-----	107.24
4	To the center of a street sign post	-----	24.54

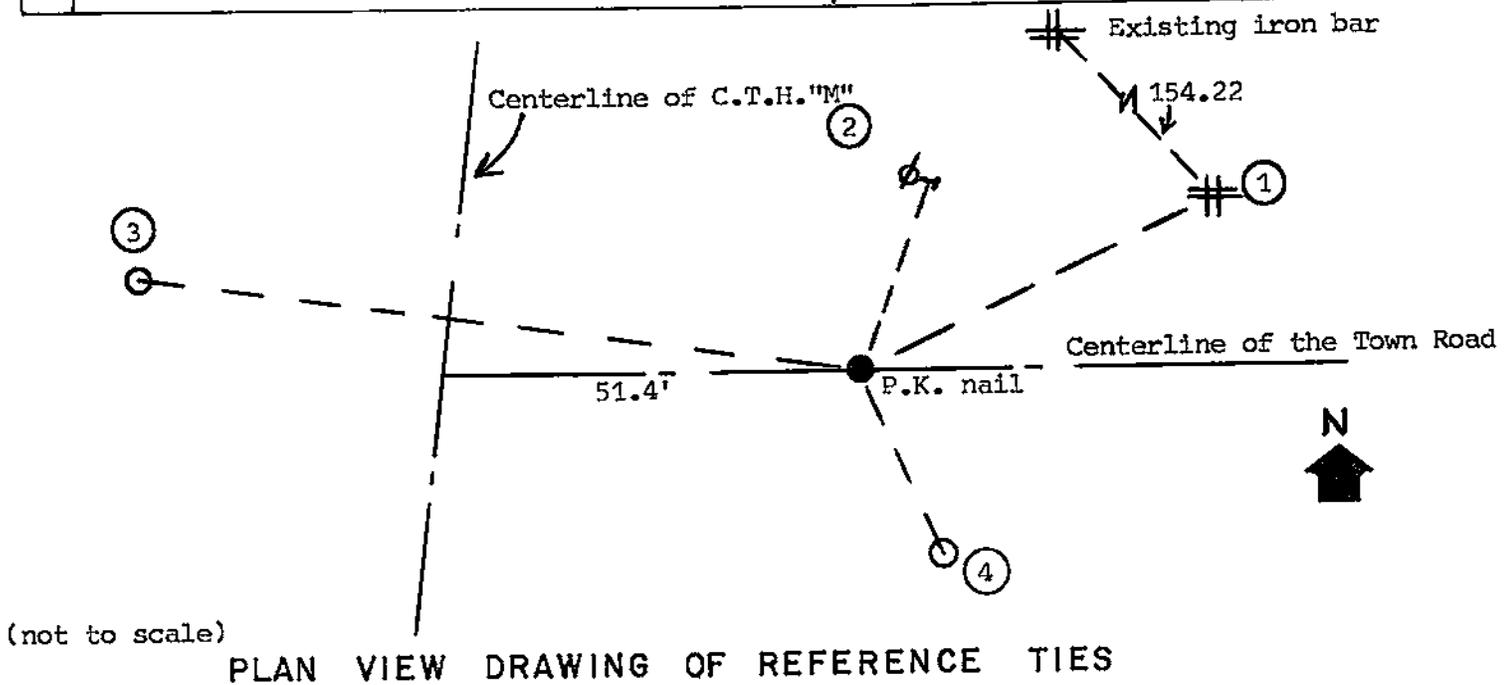

MAP SHOWING DISTANCE AND DIRECTION TO OTHER PUBLIC LAND SURVEY CORNERS USED FOR REESTABLISHING THE CORNER


(not to scale)

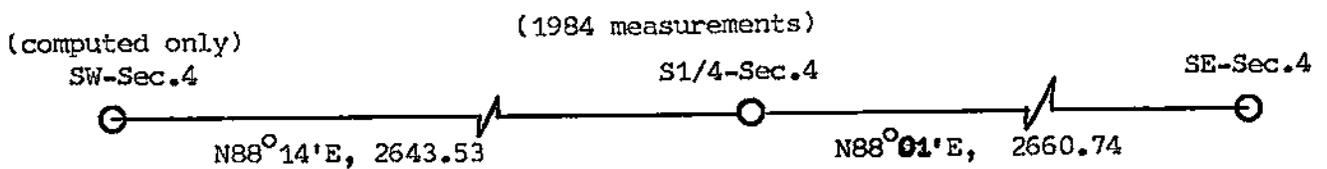

I, William C. Jung, Deputy County Surveyor,
 HEREBY CERTIFY THAT THE CORNER LOCATION SHOWN ON THIS RECORD
 WAS DETERMINED BY ME OR UNDER MY DIRECTION AND CONTROL AND
 THAT THIS U. S. PUBLIC LAND SURVEY MONUMENT RECORD IS CORRECT
 AND COMPLETE TO THE BEST OF MY KNOWLEDGE AND BELIEF.

William C. Jung
 Signature


November 6, 1991
 Date

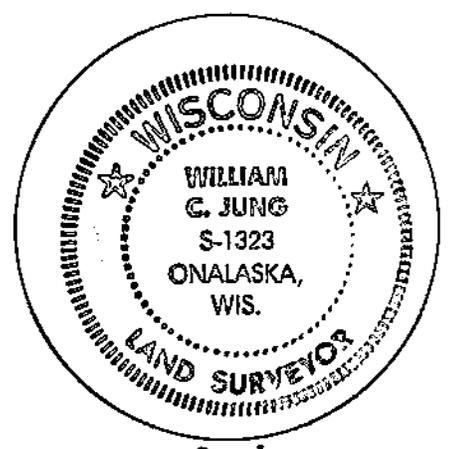

Seal

U. S. PUBLIC LAND SURVEY MONUMENT RECORD

SECTION 4 T 16 N, R 6 W, TOWN OF HAMILTON
 LA CROSSE COUNTY

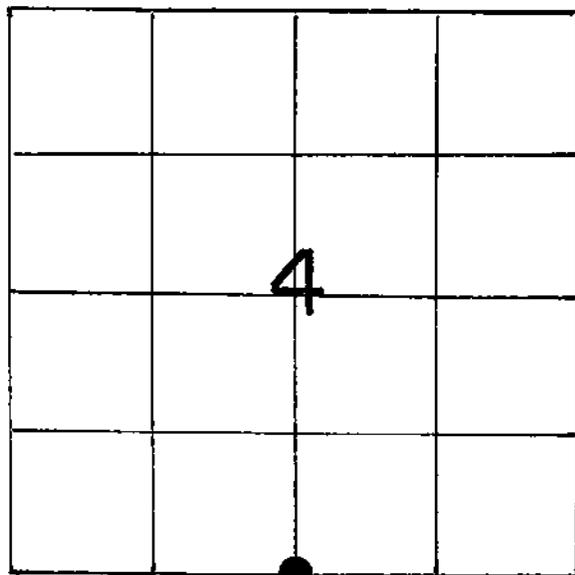

LOCATION OF LANDMARK

Crew: William Jung
 Perry Dahl
 10/1/84

WISCONSIN COORDINATE SYSTEM
North
East
Theta Angle
Horiz. Order
Vert. Order

TYPE OF LANDMARK
IRON ROD (under R.R. spike)
 BEARINGS ARE REFERENCED TO
 Assumed

Describe any record evidence, monument evidence, testimonial evidence or any other material evidence you considered and whether the monument was found or restored through acceptance of an obliterated evidence location.


Duane Marten shows an existing iron bar at this corner in 1975. Wilbur Clark shows this corner in April, 1982. I found a bent 3/4" iron bar. I removed it and replaced it with a 1/2"x18" reinforcing rod, down 5". I set a railroad spike over the rod with P.K. nails 1' West and 1' North. I think that Zietlow may have set the iron bar in 1970.

Describe or show any material discrepancy between the location of the restored corner and that of the corner previously restored or reestablished.

None known.

RECORD OF DURABLE WITNESS MONUMENTS

NO	DESCRIPTION	BEARING	DISTANCE
1	CENTER OF VENT PIPE	N78°30'W	107.26'
2	CENTER OF STREET SIGN POST	N89°12'W	83.34'
3	IRON ROD SET, 1/2" (16 1/2" long)	SOUTH	25.04'
4	IRON ROD SET, 3/4" (24" long)	NORTH	33.11'

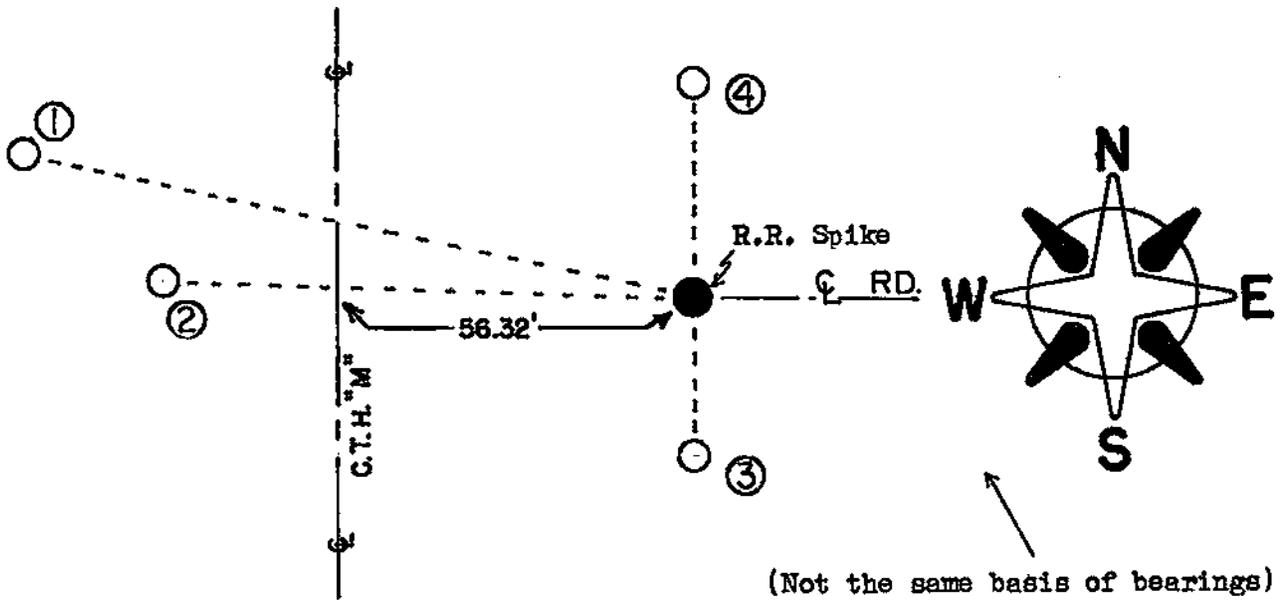


(Not the same basis of bearings)

PLAN VIEW DRAWING OF REFERENCE TIES



MAP SHOWING DISTANCE AND DIRECTION TO OTHER PUBLIC LAND SURVEY CORNERS USED FOR REESTABLISHING THE CORNER


(not to scale)

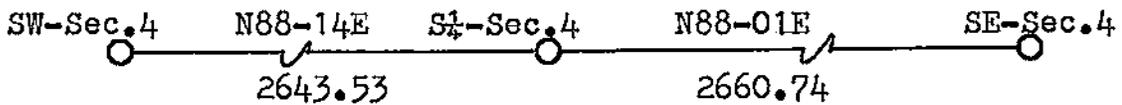

I, William C. Jung, Deputy County Surveyor,
 HEREBY CERTIFY THAT THE CORNER LOCATION SHOWN ON THIS RECORD
 WAS DETERMINED BY ME OR UNDER MY DIRECTION AND CONTROL AND
 THAT THIS U. S. PUBLIC LAND SURVEY MONUMENT RECORD IS CORRECT
 AND COMPLETE TO THE BEST OF MY KNOWLEDGE AND BELIEF.

William C. Jung
 Signature

3/14/86
 Date

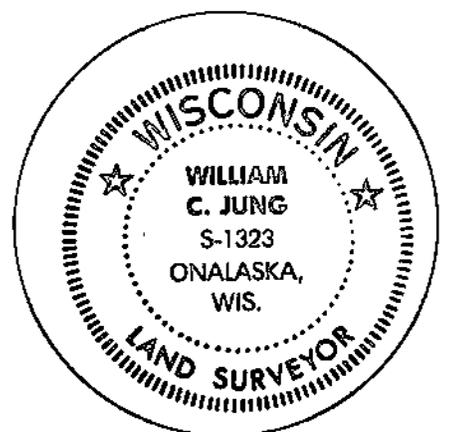

Seal