


21606050020

 U. S. PUBLIC LAND SURVEY MONUMENT RECORD

 SECTION 5, T.16N., R.6W., TOWN OF HAMILTON,
 LACROSSE COUNTY, WISCONSIN

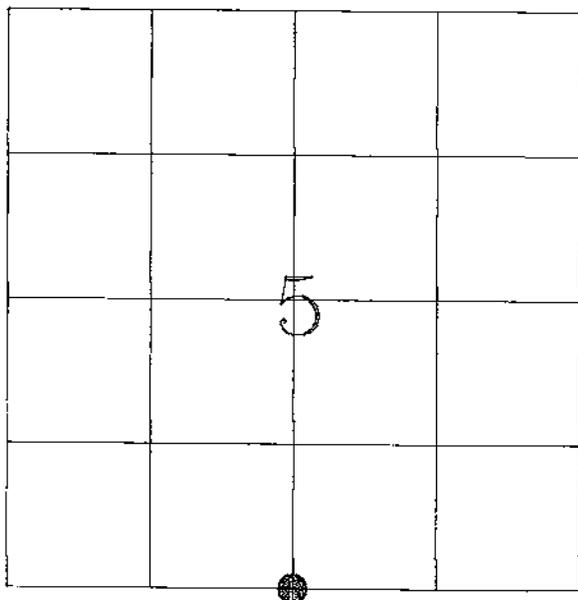

LOCATION OF LANDMARK

Crew: Rodney H. Maxwell
 Dwayne M. Hefner
 Laurence E. Johns III

Date: 18 November, 1998

WISCONSIN COORDINATE SYSTEM	
North	
East	N/A
Theta Angle	N/A
Horiz. Order	N/A
Vert. Order	N/A
TYPE OF LANDMARK:	
Found 3/4" Iron Pipe	
BEARINGS ARE REFERENCED TO:	
Assumed	

Describe any record evidence, monument evidence, testimonial evidence or any other material evidence you considered and whether the monument was found or restored through acceptance of an obliterated evidence location.


Found 3/4" iron pipe 6" under ground by 2 way fence corner (going West & North). Found this to be best available evidence of original corner. No evidence of bearing trees found, plowed fields in all directions except to the Northeast which was pasture.

Describe or show any material discrepancy between the location of the restored corner and that of the corner previously restored or reestablished.

No known record of corner being restored since original government survey. It is unknown by me at this time by whom the pipe was set. Curtis Crook located this fence corner while surveying First Addn. to Maple Grove Estates, however he does not say he found or set a pipe. Our numbers to the West agree, but we are 30' + different to the East. He also showed a dramatic change in bearing at this corner, while our measurements have this corner being almost in perfect line, between the Southwest and the computed Southeast (as per Bill Jung's breakdown of Sections 4 & 9).


RECORD OF DURABLE WITNESS MONUMENTS

NO.	DESCRIPTION	BEARING	DISTANCE
1	12" Cherry Tree in Fenceline	"North"	141.45'
2	5/8" X 24" Iron Rod on West side of 30" Red Oak.	"East"	243.0'
3	5/8" X 24" Iron Rod down 18" in field.	"South"	33.00'
4	5/8" X 24" Iron Rod on fence line.	"West"	33.00'

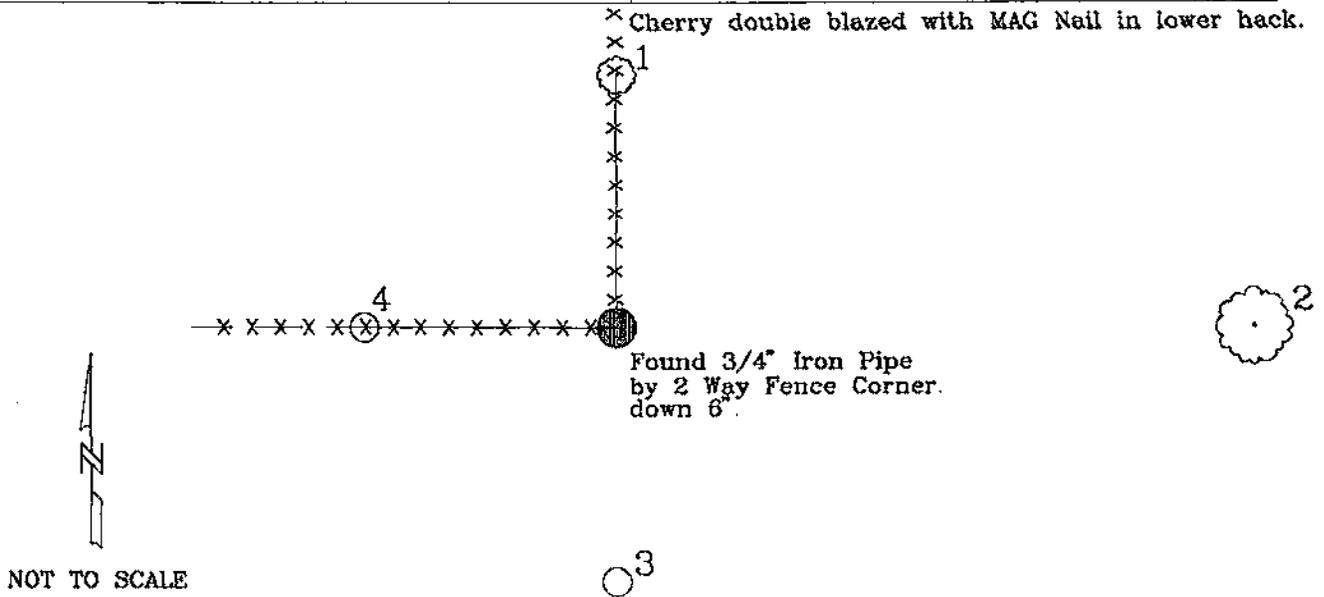

PLAN VIEW DRAWING OF REFERENCE TIES

MAP SHOWING DISTANCE AND DIRECTION TO OTHER PUBLIC LAND SURVEY CORNERS USED FOR REESTABLISHING THE CORNER

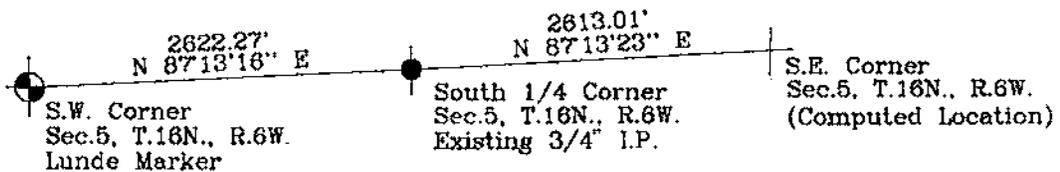

I, RODNEY H. MAXWELL, REGISTERED LAND SURVEYOR, HEREBY CERTIFY THAT THE CORNER LOCATION SHOWN ON THIS RECORD WAS DETERMINED BY ME OR UNDER MY DIRECTION AND CONTROL, AND THAT THIS U. S. PUBLIC LAND SURVEY MONUMENT RECORD IS CORRECT AND COMPLETE TO THE BEST OF MY KNOWLEDGE AND BELIEF.

Rodney H. Maxwell

Rodney H. Maxwell
Maxwell Surveying
7457 Highway 16, Suite C
Sparta, Wisconsin
30 December, 1998

