


21606060020

U. S. PUBLIC LAND SURVEY MONUMENT RECORD

SECTION 7 T 16 N, R 6 W, TOWN OF HAMILTON

LA CROSSE COUNTY

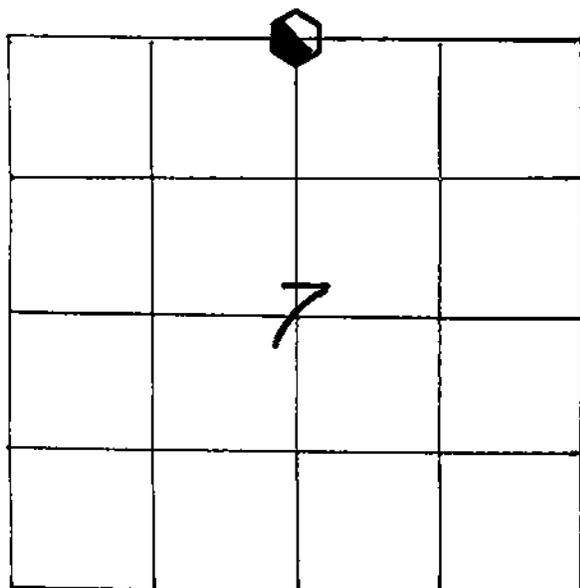

LOCATION OF LANDMARK

CREW: **WILLIAM C. JUNG**
PETER F. FOLLANSBEE
 DATE: **2/01/2006**

WISCONSIN COORDINATE SYSTEM

North **688,905.935**East **1,667,692.636**

Theta Angle

Horiz. Order

Vert. Order

DATUM: **1983('91)**

TYPE OF LANDMARK

30" ALUMINUM BERNTSEN MARKER.

BEARINGS ARE REFERENCED TO

Describe any record evidence, monument evidence, testimonial evidence or any other material evidence you considered and whether the monument was found or restored through acceptance of an obliterated evidence location.


Paul Fairchild set a nail at this corner. It was set at the single proportionate position. I agree with this. The nail was removed and replaced with a Berntsen marker.

Describe or show any material discrepancy between the location of the restored corner and that of the corner previously restored or reestablished.


NONE KNOWN.

RECORD OF DURABLE WITNESS MONUMENTS

| NO | DESCRIPTION | MAGNETIC BEARING | DISTANCE |
|----|--|------------------|----------------|
| 1 | SET A NAIL IN N.W.-SIDE OF A 10" WHITE OAK | S 53° W | SLOPE = 33.93' |
| 2 | SET A NAIL IN N.E.-SIDE OF A 9" BURR OAK | N 30° W | 17.40 FT. |
| 3 | SET A NAIL IN N.W.-SIDE OF A 7" WHITE OAK | N 40° E | 23.69 FT. |
| 4 | SET A NAIL IN S.W.-SIDE OF A 17" BURR OAK | S 40° E | 48.34 FT. |

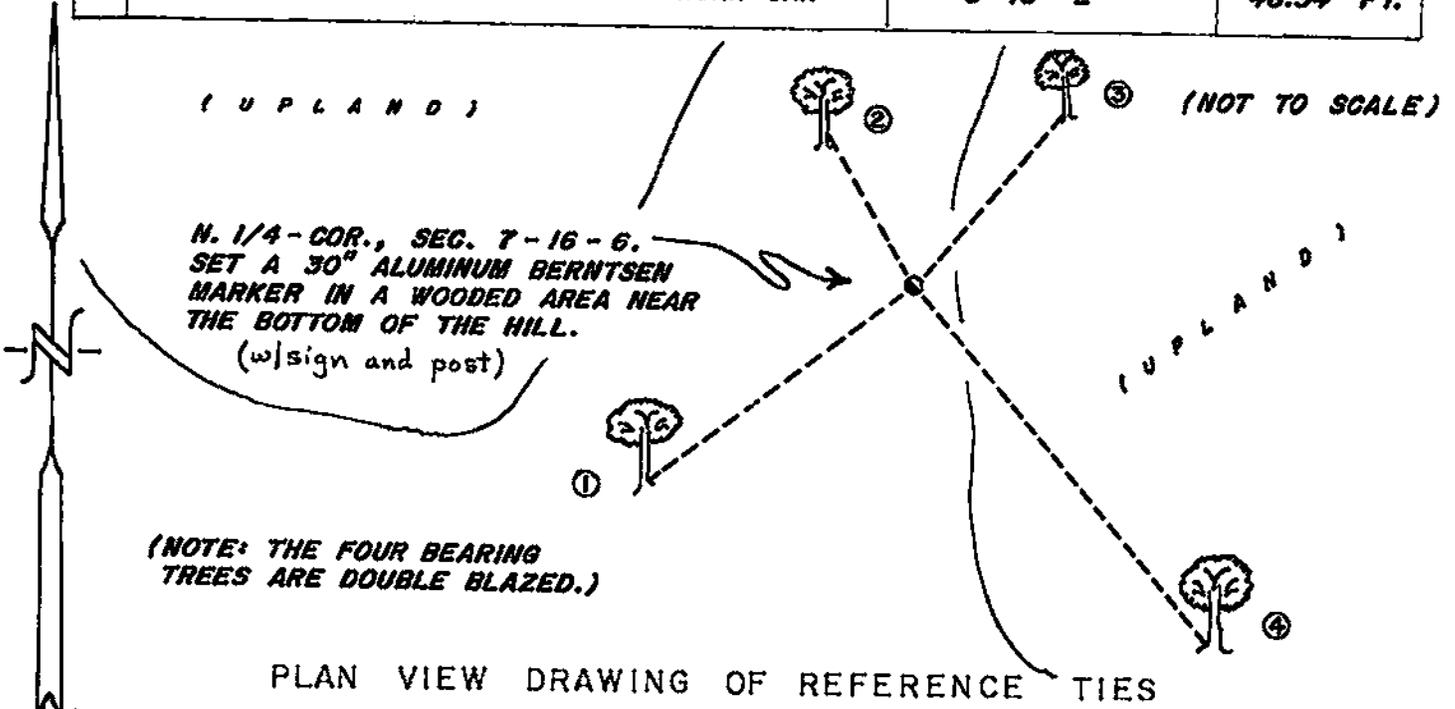


MAP SHOWING DISTANCE AND DIRECTION TO OTHER PUBLIC LAND SURVEY CORNERS USED FOR REESTABLISHING THE CORNER

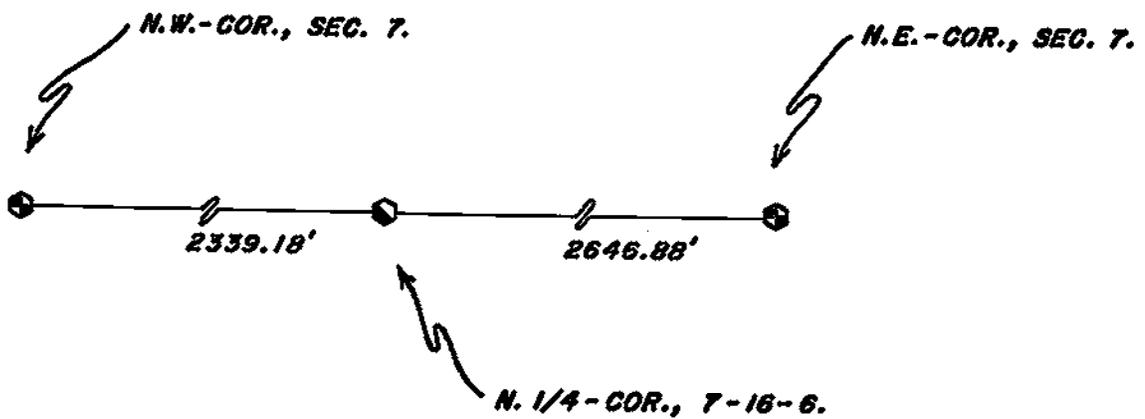

I, WILLIAM C. JUNG, COUNTY SURVEYOR
 HEREBY CERTIFY THAT THE CORNER LOCATION SHOWN ON THIS RECORD
 WAS DETERMINED BY ME OR UNDER MY DIRECTION AND CONTROL AND
 THAT THIS U. S. PUBLIC LAND SURVEY MONUMENT RECORD IS CORRECT
 AND COMPLETE TO THE BEST OF MY KNOWLEDGE AND BELIEF.

William C. Jung 3/3/06
 Signature Date

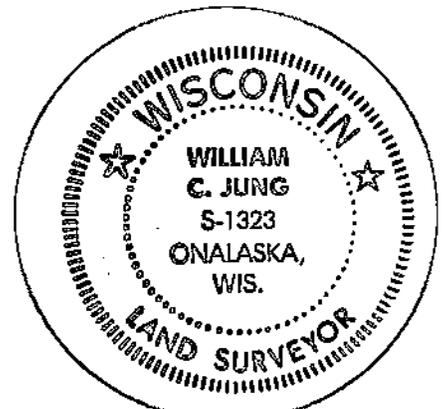

Seal