


21606062000

U. S. PUBLIC LAND SURVEY MONUMENT RECORD

SECTION 5 T 16 N, R 6 W, TOWN OF HAMILTON

LA CROSSE COUNTY

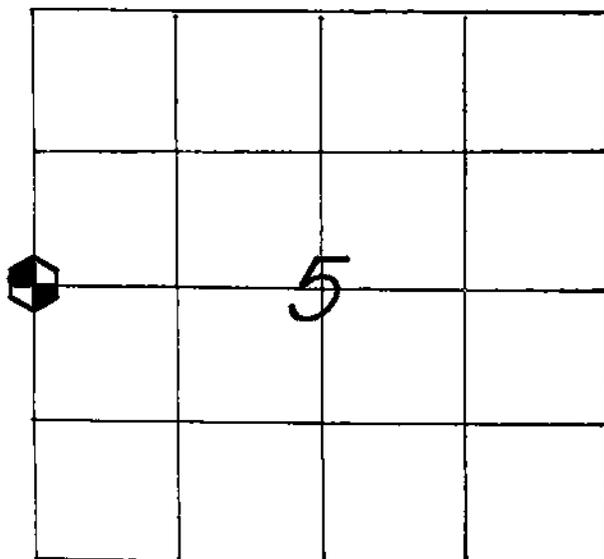

LOCATION OF LANDMARK

CREW: WILLIAM C. JUNG
 PETER F. FOLLANSBEE
 DATE: 4/19/2007

WISCONSIN COORDINATE SYSTEM

North 691,566.167

East 1,670,292.372

Theta Angle

Horiz. Order

Vert. Order

DATUM: 1983('91)

TYPE OF LANDMARK

BRASS CAP LUNDE MARKER.

BEARINGS ARE REFERENCED TO

GRID NORTH AS PER SECTION DATA.

Describe any record evidence, monument evidence, testimonial evidence or any other material evidence you considered and whether the monument was found or restored through acceptance of an obliterated evidence location.


I found the pipe that Maxwell found and replaced it with a Lunde marker. A sign and post were set nearby. The old occupied corner fits very well.

Describe or show any material discrepancy between the location of the restored corner and that of the corner previously restored or reestablished.

NONE KNOWN.


RECORD OF DURABLE WITNESS MONUMENTS

NO	DESCRIPTION	BEARING	DISTANCE
1	EXISTING 5/8" x 24" IRON ROD UNDER THE FENCE	NORTH ±	32.82 FT.
2	EXISTING 5/8" x 24" IRON ROD BURIED 18" IN FIELD	EAST ±	33.03 FT.
3	EXISTING 5/8" x 24" IRON ROD BURIED 18" IN FIELD	SOUTH ±	33.00 FT.
4	EXISTING 5/8" x 24" IRON ROD UNDER THE FENCE	WEST ±	33.48 FT.

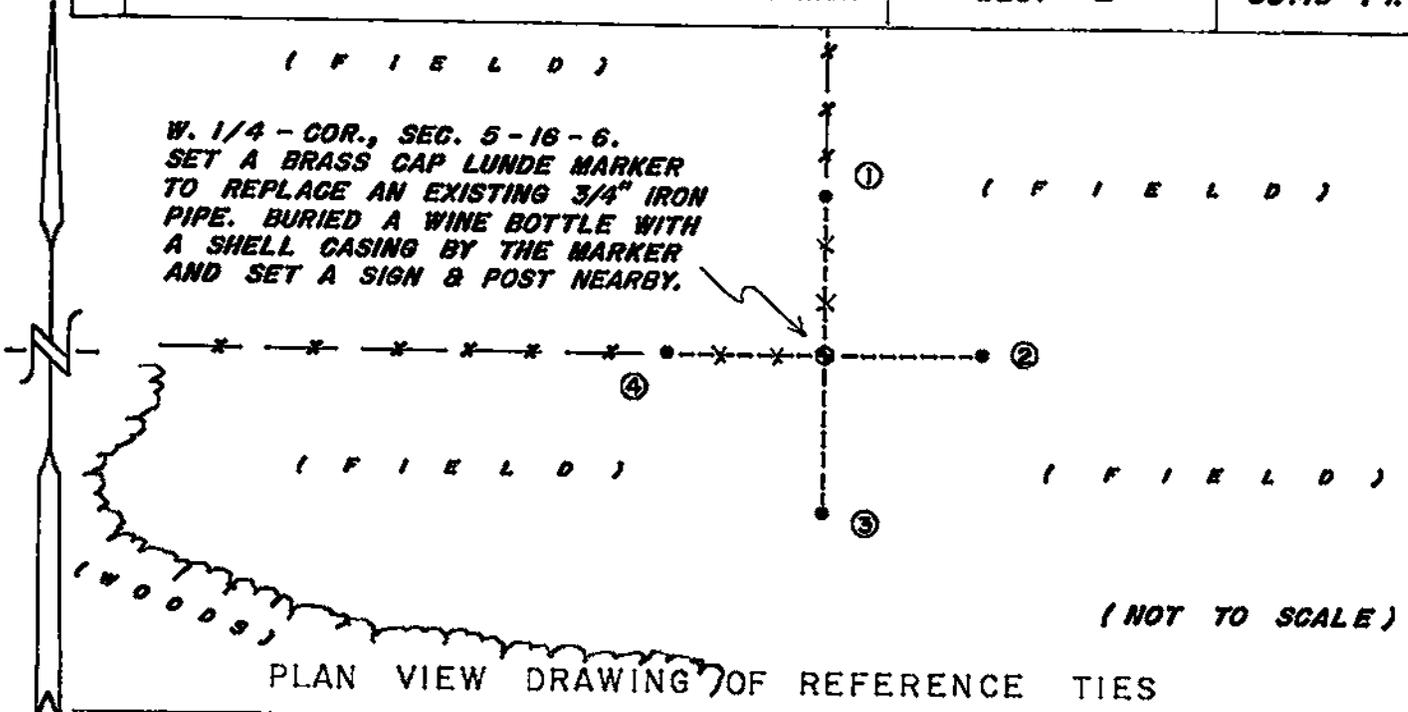

MAP SHOWING DISTANCE AND DIRECTION TO OTHER PUBLIC LAND SURVEY CORNERS USED FOR REESTABLISHING THE CORNER


(GRID BEARINGS AND DISTANCES)
 (GRID FACTOR: 0.99994)
 (NOT TO SCALE)

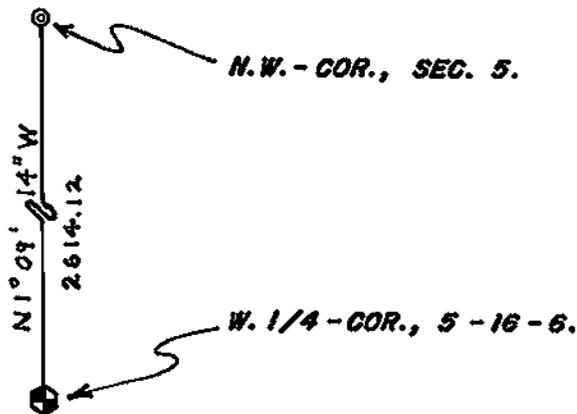

I, WILLIAM C. JUNG, COUNTY SURVEYOR
 HEREBY CERTIFY THAT THE CORNER LOCATION SHOWN ON THIS RECORD
 WAS DETERMINED BY ME OR UNDER MY DIRECTION AND CONTROL AND
 THAT THIS U. S. PUBLIC LAND SURVEY MONUMENT RECORD IS CORRECT
 AND COMPLETE TO THE BEST OF MY KNOWLEDGE AND BELIEF.


William C. Jung
 Signature

7/18/07
 Date

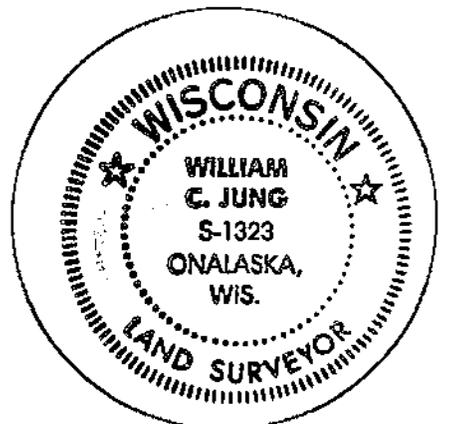

Seal

 U. S. PUBLIC LAND SURVEY MOUMENT RECORD

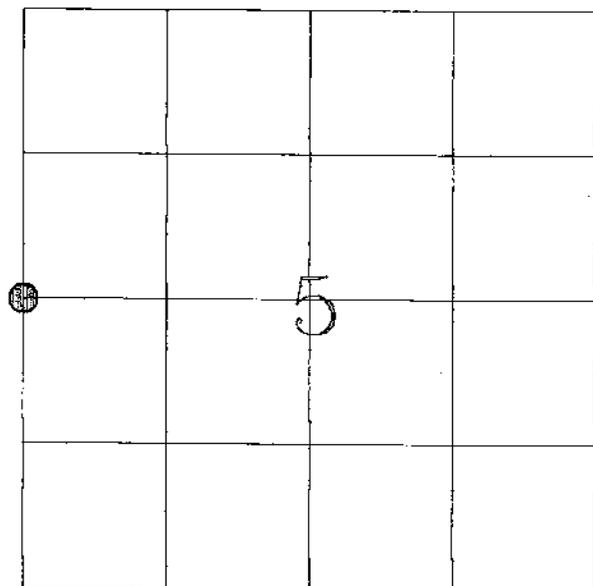 SECTION 5, T.16N., R.6W., TOWN OF HAMILTON,
 LACROSSE COUNTY, WISCONSIN


LOCATION OF LANDMARK

 Crew: Rodney H. Maxwell
 Dwayne M. Hefner
 Laurence E. Johns III

Date: 18 November, 1998

WISCONSIN COORDINATE SYSTEM	
North	N/A
East	N/A
Theta Angle	N/A
Horiz. Order	N/A
Vert. Order	N/A
TYPE OF LANDMARK:	
Found 3/4" Iron Pipe	
BEARINGS ARE REFERENCED TO:	
the North line of the N.W.1/4 of Section 4, recorded to bear N87°34'00"E.	

 Describe any record evidence, monument evidence, testimonial evidence or any other material evidence you considered and whether the monument was found or restored through acceptance of an obliterated evidence location.


Found 3/4" iron pipe 4" under ground by 2 way fence corner (going West & North). Found this to be best available evidence of original corner. No evidence of bearing trees found, plowed fields in all directions.

 Describe or show any material discrepancy between the location of the restored corner and that of the corner previously restored or reestablished.

No known record of corner being restored since original government survey. It is unknown by me at this time by whom the pipe was set.


RECORD OF DURABLE WITNESS MONUMENTS

NO.	DESCRIPTION	BEARING	DISTANCE
1	5/8" X 24" Iron Rod on fence line.	"North"	33.00'
2	5/8" X 24" Iron Rod down 18" on field break.	"East"	33.00'
3	5/8" X 24" Iron Rod down 18" in field.	"South"	33.00'
4	5/8" X 24" Iron Rod on fence line.	"West"	33.00'

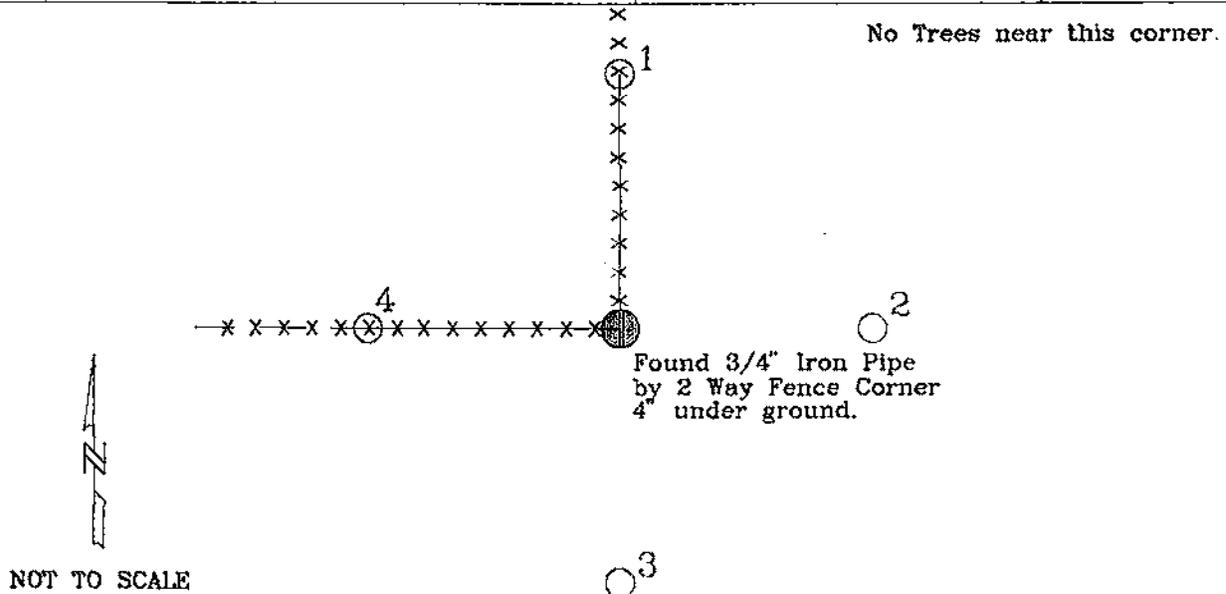

PLAN VIEW DRAWING OF REFERENCE TIES


MAP SHOWING DISTANCE AND DIRECTION TO OTHER PUBLIC LAND SURVEY CORNERS USED FOR REESTABLISHING THE CORNER

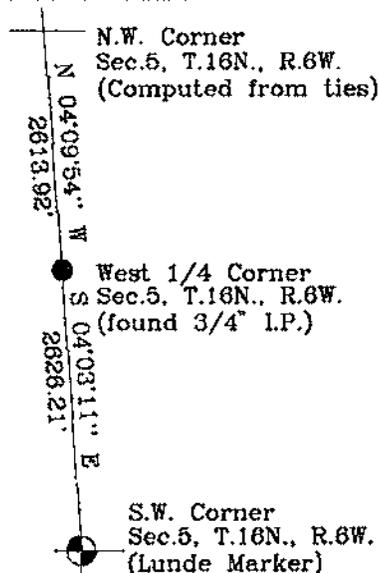

I, RODNEY H. MAXWELL, REGISTERED LAND SURVEYOR, HEREBY CERTIFY THAT THE CORNER LOCATION SHOWN ON THIS RECORD WAS DETERMINED BY ME OR UNDER MY DIRECTION AND CONTROL, AND THAT THIS U. S. PUBLIC LAND SURVEY MONUMENT RECORD IS CORRECT AND COMPLETE TO THE BEST OF MY KNOWLEDGE AND BELIEF.

Rodney H. Maxwell

Rodney H. Maxwell
Maxwell Surveying
7457 Highway 16, Suite C
Sparta, Wisconsin
30 December, 1998

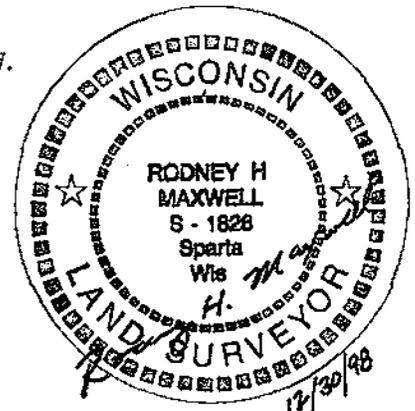

SEAL