


21606070020

U. S. PUBLIC LAND SURVEY MONUMENT RECORD

SECTION 7 T 16 N, R 6 W, TOWN OF HAMILTON

LA CROSSE COUNTY

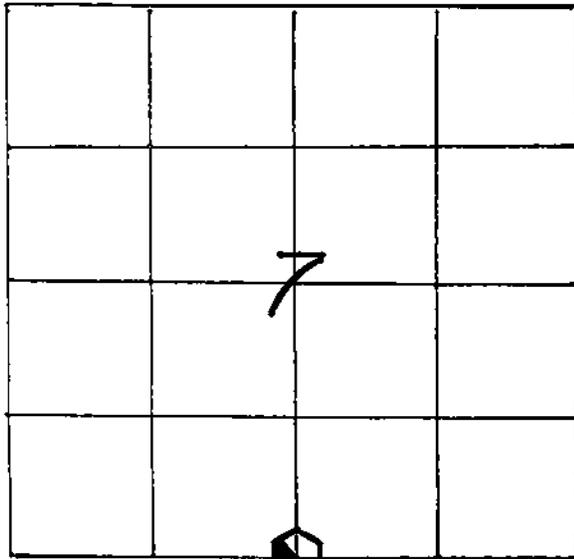

LOCATION OF LANDMARK

CREW: *WILLIAM C. JUNG*
PETER F. FOLLANSBEE
 DATE: *2/02/2006*

WISCONSIN COORDINATE SYSTEM	
North	<i>683,659.226</i>
East	<i>1,667,636.219</i>
Theta Angle	
Horiz. Order	
Vert. Order	
DATUM:	<i>1983('91)</i>
TYPE OF LANDMARK	
<i>30" ALUMINUM BERNTSEN MARKER.</i>	
BEARINGS ARE REFERENCED TO	
<i>GRID NORTH AS PER SECTION DATA.</i>	

Describe any record evidence, monument evidence, testimonial evidence or any other material evidence you considered and whether the monument was found or restored through acceptance of an obliterated evidence location.


Paul Fairchild set a nail at this corner. It was set at the single proportionate position. I agree with this. The nail was removed and replaced with a Berntsen marker. I did not find the stone of record from 1878.

Describe or show any material discrepancy between the location of the restored corner and that of the corner previously restored or reestablished.

NONE KNOWN.


RECORD OF DURABLE WITNESS MONUMENTS

NO	DESCRIPTION	MAGNETIC	
		BEARING	DISTANCE
1	SET A NAIL IN S.W.-SIDE OF A 13" BOX ELDER	N 52° W	37.58 FT.
2	SET A NAIL IN S.W.-SIDE OF A 12½" BOX ELDER	N 25° W	20.95 FT.
3	SET A NAIL IN S.W.-SIDE OF A 15" BOX ELDER	N 21° E	36.76 FT.
4	SET A NAIL IN N.-SIDE OF A 15" BOX ELDER	N 71° E	17.78 FT.

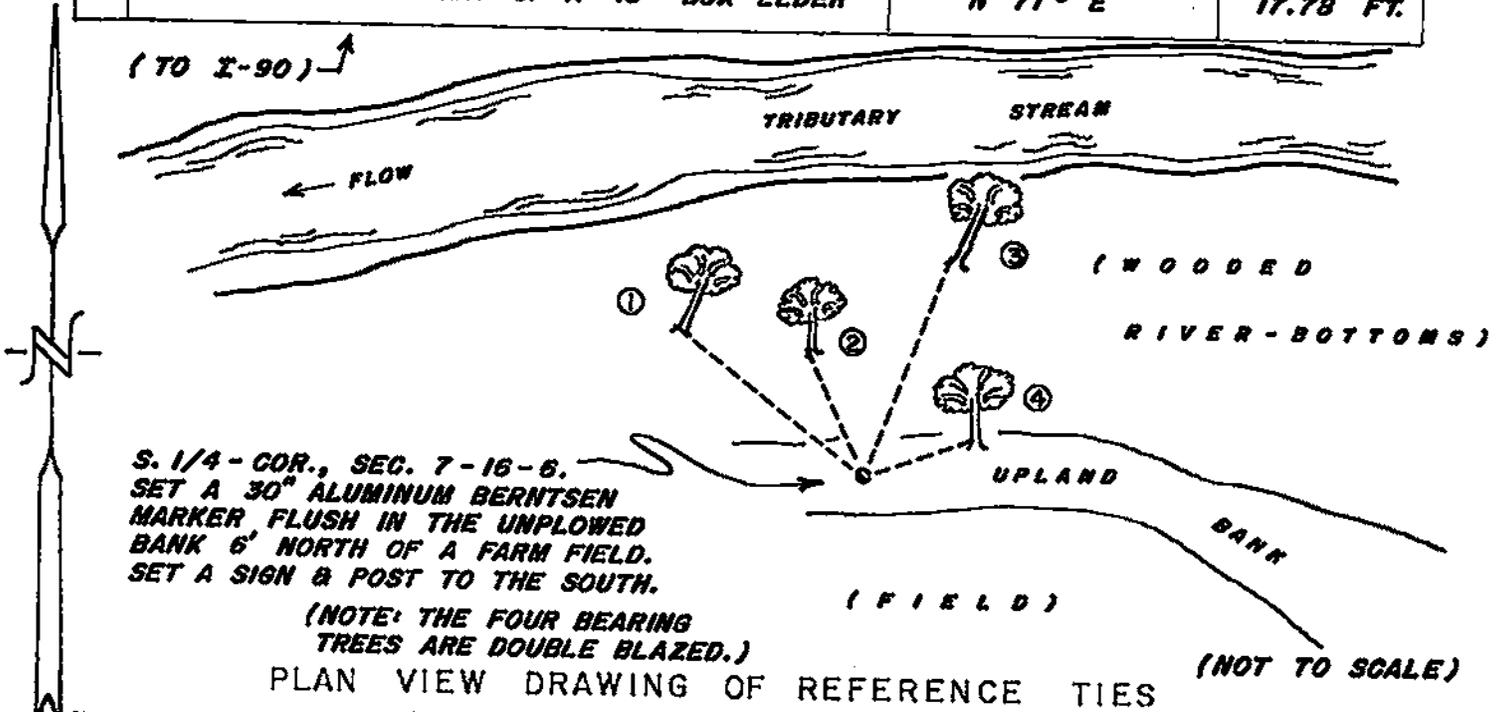


MAP SHOWING DISTANCE AND DIRECTION TO OTHER PUBLIC LAND SURVEY CORNERS USED FOR REESTABLISHING THE CORNER

(GRID BEARINGS - GROUND DISTANCES)
(GRID FACTOR: 0.99993)
(NOT TO SCALE)

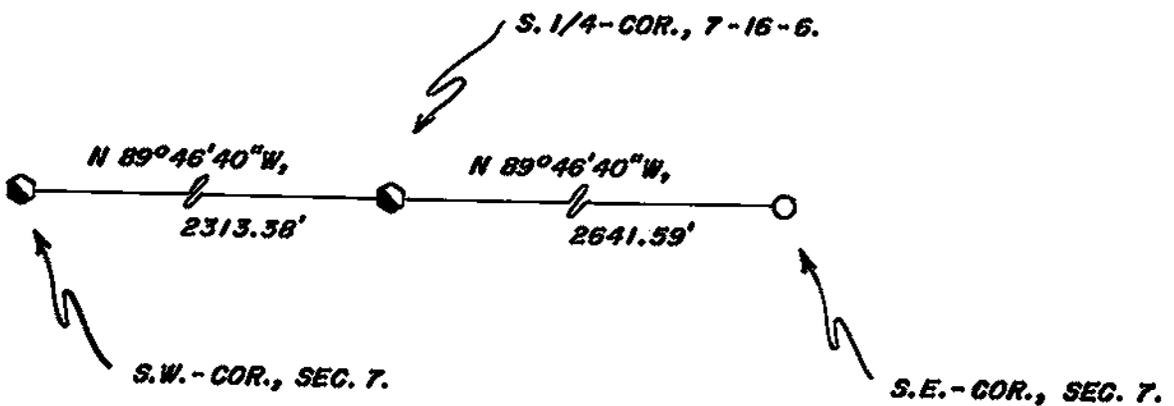

I, WILLIAM C. JUNG, COUNTY SURVEYOR
HEREBY CERTIFY THAT THE CORNER LOCATION SHOWN ON THIS RECORD WAS DETERMINED BY ME OR UNDER MY DIRECTION AND CONTROL AND THAT THIS U. S. PUBLIC LAND SURVEY MONUMENT RECORD IS CORRECT AND COMPLETE TO THE BEST OF MY KNOWLEDGE AND BELIEF.

William C. Jung 3/3/06
Signature Date

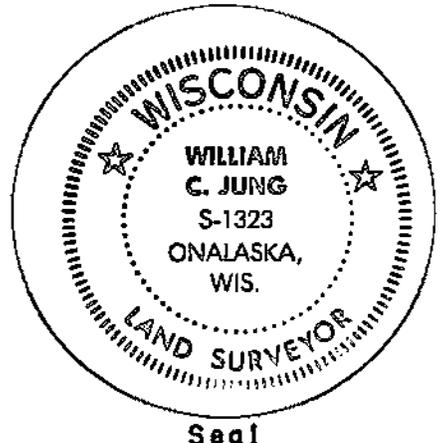

Seal