


21606080000

## U. S. PUBLIC LAND SURVEY MONUMENT RECORD

SECTION 9 T 16 N, R 6 W, TOWN OF HAMILTON

LA CROSSE COUNTY

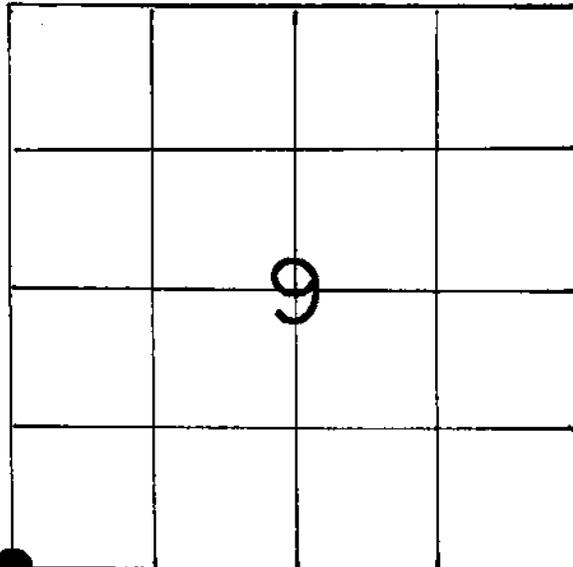

LOCATION OF LANDMARK

Crew: William Jung  
Perry Dahl  
10/11/84

Crew: William C. Jung  
Peter Follansbee  
4/26/99 and 9/22/99

WISCONSIN COORDINATE SYSTEM

North

East

Theta Angle

Horiz. Order

Vert. Order

TYPE OF LANDMARK P.K. nail and cap  
over 1/2" IRON ROD

BEARINGS ARE REFERENCED TO

Assumed

Describe any record evidence, monument evidence, testimonial evidence or any other material evidence you considered and whether the monument was found or restored through acceptance of an obliterated evidence location.

This shows as the corner on the old highway map. Curtis Crook shows this as the corner in 1978 as did Dave Krohn. I found a nail at the occupied corner, removed the nail, and replaced it with a 1/2"x16" rebar. I accepted this occupied corner at the road intersection as the best available evidence of the original government corner position.


The road was repaved in 1999. The rod is now under the pavement. A P.K. nail and cap were set in the new road.

Describe or show any material discrepancy between the location of the restored corner and that of the corner previously restored or reestablished.


None known.

RECORD OF DURABLE WITNESS MONUMENTS

| NO | DESCRIPTION                 | BEARING               | DISTANCE |
|----|-----------------------------|-----------------------|----------|
| 1  | CENTER OF 12" UNBLAZED TREE | $\pm$ N63°W = Ass.    | 59.15'±  |
| 2  | CENTER OF 12" UNBLAZED TREE | $\pm$ S69°W = Ass.    | 56.85'±  |
| 3  | SET 1/2" IRON ROD           | N88°E = Mag.          | 1319'    |
| 4  | U.S.G.S. BRASS CAP MONUMENT | $\pm$ N58°54'E = Ass. | 49.03'   |

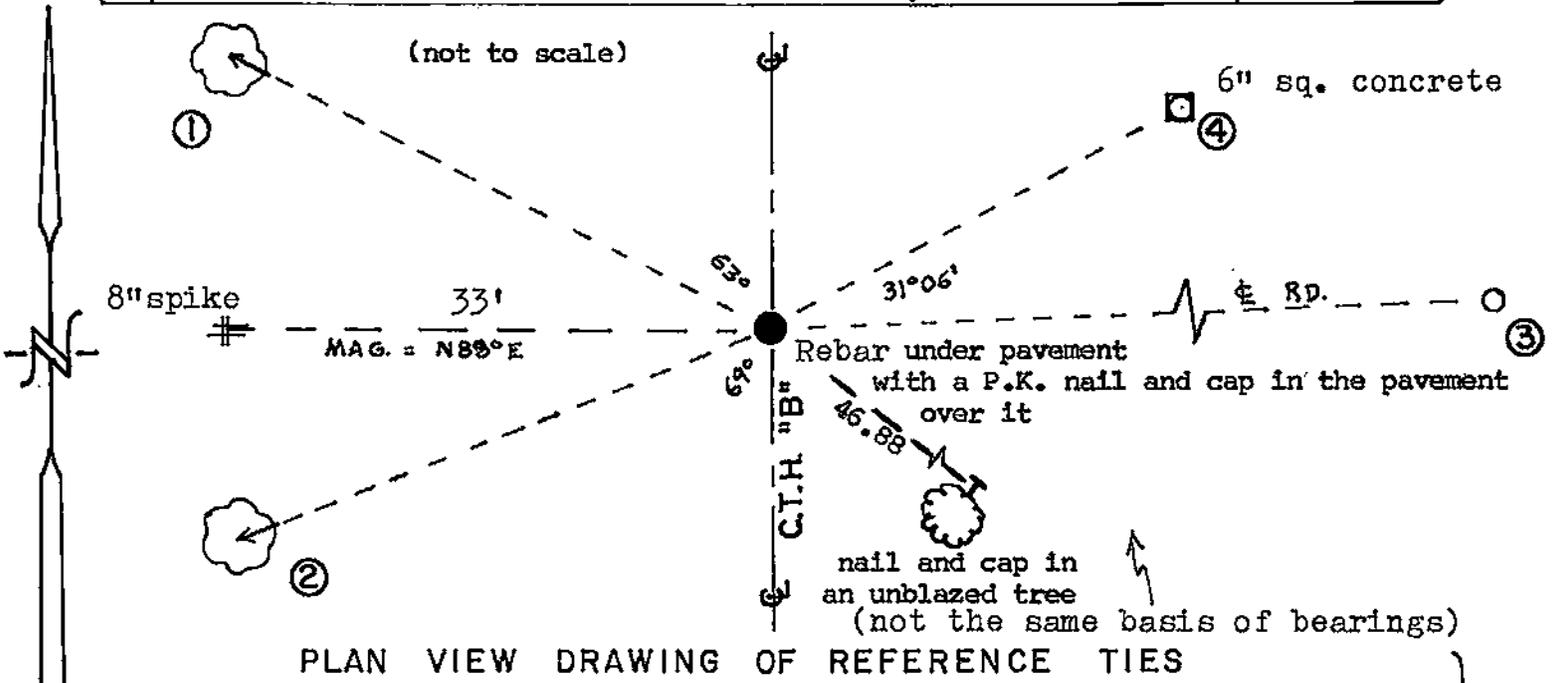

MAP SHOWING DISTANCE AND DIRECTION TO OTHER PUBLIC LAND SURVEY CORNERS USED FOR REESTABLISHING THE CORNER

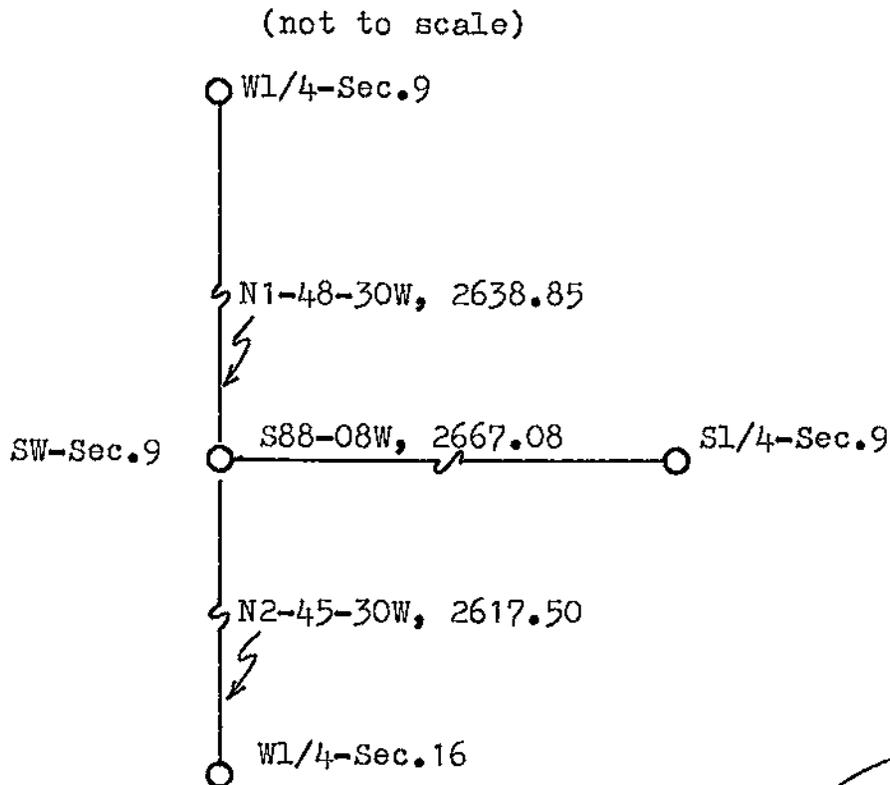

I, William C. Jung, Deputy County Surveyor,  
 HEREBY CERTIFY THAT THE CORNER LOCATION SHOWN ON THIS RECORD  
 WAS DETERMINED BY ME OR UNDER MY DIRECTION AND CONTROL AND  
 THAT THIS U. S. PUBLIC LAND SURVEY MONUMENT RECORD IS CORRECT  
 AND COMPLETE TO THE BEST OF MY KNOWLEDGE AND BELIEF.

William C. Jung  
 Signature

3/14/86  
 Date  
 Revised: 9/24/99 *wcj*

