


## U. S. PUBLIC LAND SURVEY MONUMENT RECORD

SECTION 9 T 16 N, R 6 W, TOWN OF HAMILTON

LA CROSSE COUNTY

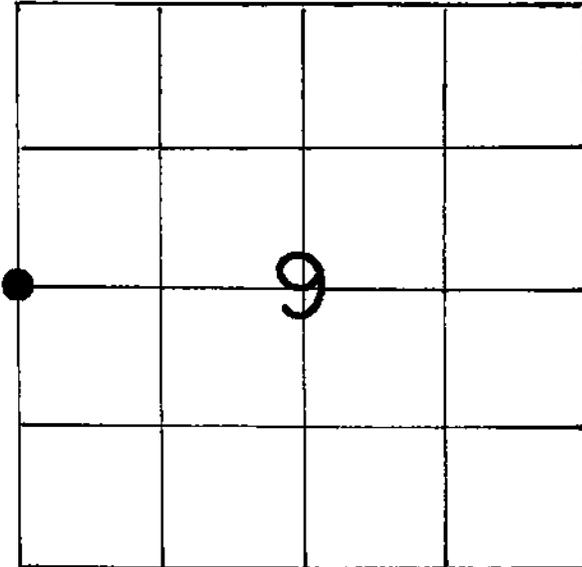

## LOCATION OF LANDMARK

Crew: William Jung  
Perry Dahl

11/20/84

## WISCONSIN COORDINATE SYSTEM

North

East

Theta Angle

Horiz. Order

Vert. Order

## TYPE OF LANDMARK

Berntsen Monument

## BEARINGS ARE REFERENCED TO

Assumed

Describe any record evidence, monument evidence, testimonial evidence or any other material evidence you considered and whether the monument was found or restored through acceptance of an obliterated evidence location.

I set this corner by intersecting the occupied West line of Section 9 with the occupied North line of the SE1/4 of Section 9 projected West. I set a Berntsen monument at the corner. I found no evidence of the old corner, other than the North-South fence.

Describe or show any material discrepancy between the location of the restored corner and that of the corner previously restored or reestablished.

This does not agree with the position as shown on Curtis Crook's map done in 1978. I discussed this problem with Gary Watts from Davy Engr. He agrees with my final corner position.

