


U. S. PUBLIC LAND SURVEY MONUMENT RECORD

SECTION 16 T 16 N, R 6 W, TOWN OF HAMILTON
LA CROSSE COUNTY

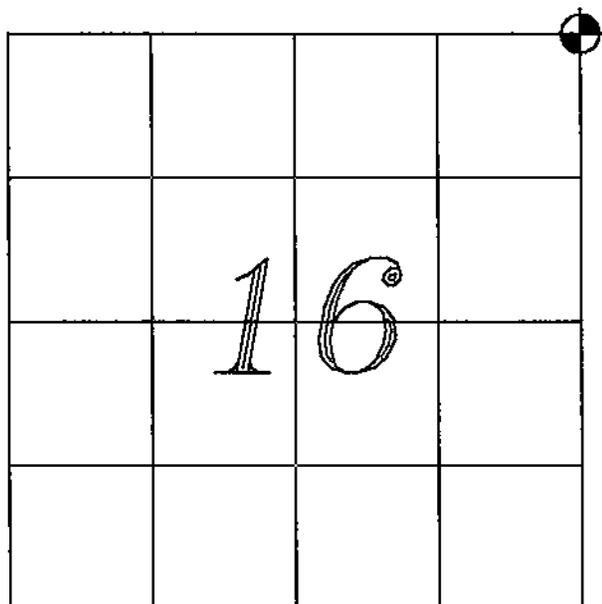

LOCATION OF LANDMARK

CREW: Chris Fechner
 Jake Spees

DATE: 12-24-03

Describe any record evidence, monument evidence, testimonial evidence, or any other material evidence you considered and whether the monument was found or restored through acceptance of an obliterated evidence location.

The North-South fence line is almost exactly 2640 feet from the N 1/4 corner of Section 15. A cattle lane presents two East-West fences. I placed the corner 2640.00 feet from the N 1/4 corner of Section 15 on line with the N 1/4 corner of Section 16. The distances North and South fit very well with the existing monumentation.


Describe or show any material discrepancy between the location of the restored corner and that of the corner previously restored or reestablished.

NONE KNOWN

| |
|--|
| WISCONSIN COORDINATE SYSTEM |
| North |
| East |
| Theta Angle |
| Horiz. Order |
| Vert. Order |
| TYPE OF LANDMARK |
| 3/4" X 24" Iron Bar (1.50 lb/lin. ft.) |
| BEARINGS ARE REFERENCED TO |
| <i>La Crosse County Coordinate System</i> |


RECORD OF DURABLE WITNESS MONUMENTS

| NO | DESCRIPTION | BEARING | DISTANCE |
|----|---|---------------|----------|
| 1 | <i>3/4" X 24" Iron Bar (1.50 lb/lin. ft.)</i> | N 78°33'23" E | 26.17' |
| 2 | <i>3/4" X 24" Iron Bar (1.50 lb/lin. ft.)</i> | N 14°31'35" E | 40.38' |
| 3 | <i>3/4" X 24" Iron Bar (1.50 lb/lin. ft.)</i> | N 82°06'47" W | 43.33' |
| 4 | <i>3/4" X 24" Iron Bar (1.50 lb/lin. ft.)</i> | S 11°02'04" W | 36.25' |

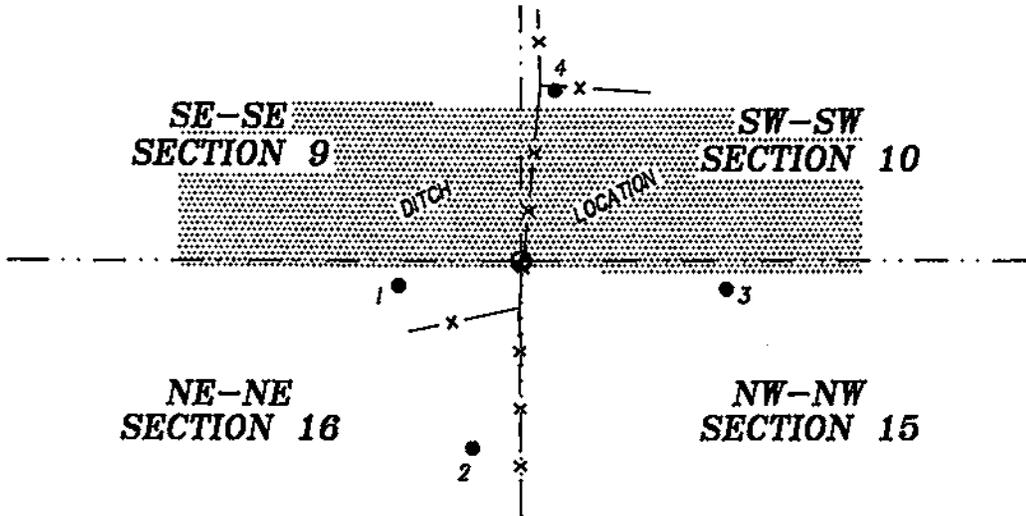

PLAN VIEW DRAWING OF REFERENCE TIES

MAP SHOWING DISTANCE AND DIRECTION TO OTHER PUBLIC LAND SURVEY CORNERS USED FOR REESTABLISHING THE CORNER

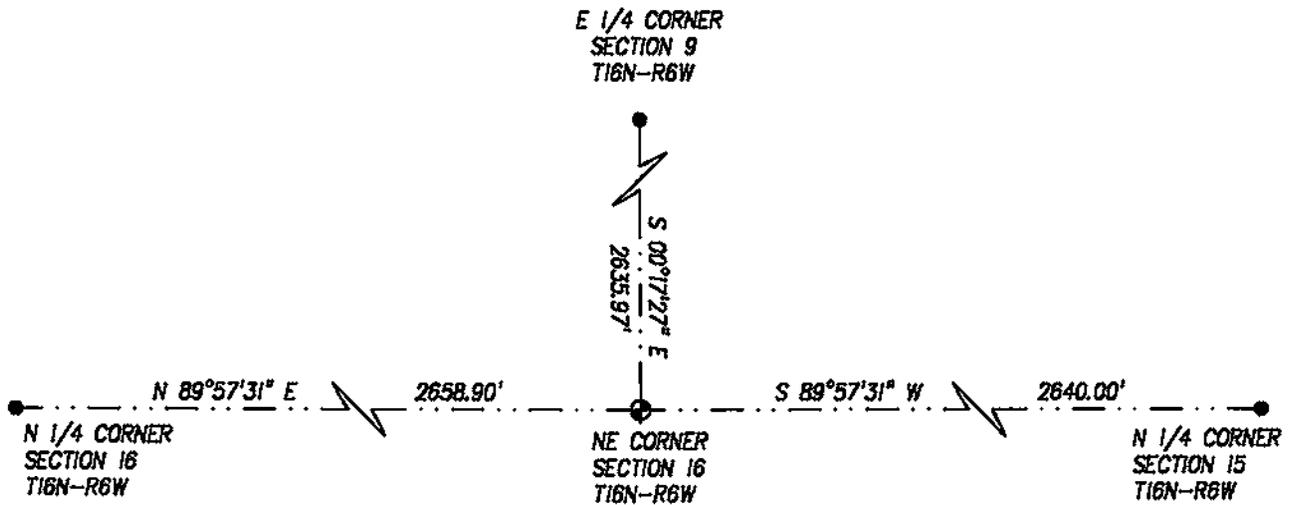

I, Christopher W. Fechner
 HEREBY CERTIFY THAT THE CORNER LOCATION SHOWN ON THIS RECORD
 WAS DETERMINED BY ME OR UNDER MY DIRECTION AND CONTROL AND
 THAT THIS U. S. PUBLIC LAND SURVEY MONUMENT RECORD IS CORRECT
 AND COMPLETE TO THE BEST OF MY KNOWLEDGE AND BELIEF.

Christopher W. Fechner 3/11/04

Signature

Date



Seal

#59

William C. Jung, County Surveyor
LA CROSSE COUNTY, WISCONSIN

Administrative Center • Room 104
400 4th Street North • La Crosse, Wisconsin 54601-3200



(608) 785-9722
9626

To Whom It May Concern:

This is to certify that on April 14, 2004, Peter Follansbee and I were at the Northeast corner of Section 16, T16N-R6W, that we found a 3/4" iron bar at the corner, that we removed the iron bar and replaced it with a brass capped Lunde marker, that we set a post with a warning sign, and that as a memorial to the Lunde we also buried a beer bottle with a shell casing.

William C. Jung

William C. Jung
LaCrosse County Surveyor

January 24, 2005

