


21606090020

U. S. PUBLIC LAND SURVEY MONUMENT RECORD

SECTION 9 T 16 N, R 6 W, TOWN OF HAMILTON
 LA CROSSE COUNTY

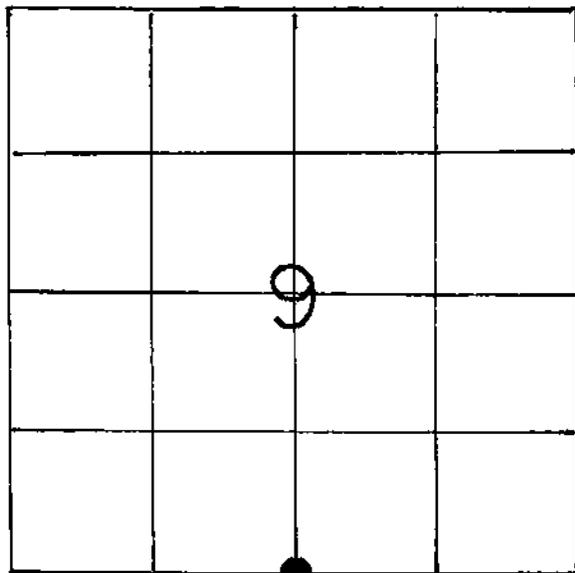

LOCATION OF LANDMARK

WISCONSIN COORDINATE SYSTEM
North
East
Theta Angle
Horiz. Order
Vert. Order
TYPE OF LANDMARK
1/2" IRON ROD Railroad spike
BEARINGS ARE REFERENCED TO
Assumed

Crew: William Jung
 Perry Dahl
 11/7/84

Crew: William C. Jung
 Peter F. Follansbee
 7/9/92

Describe any record evidence, monument evidence, testimonial evidence or any other material evidence you considered and whether the monument was found or restored through acceptance of an obliterated evidence location.

I found a P.K. nail at the occupied corner. This shows as the corner on the hwy. map. The location appears to fit the old school deed. Curtis Crook shows this as the corner in 1978. I removed the P.K. nail and replaced it with a 1/2"x16" rebar. I accepted the occupied corner as the best available evidence of the original government corner position.

***** (see below)

Describe or show any material discrepancy between the location of the restored corner and that of the corner previously restored or reestablished.


None known.

***** 1992 notes:

The rebar was destroyed during highway construction. A railroad spike was set in the new pavement.


RECORD OF DURABLE WITNESS MONUMENTS

NO	DESCRIPTION	BEARING	DISTANCE
1	CORNER OF STEEL FENCE POST	N53°28'W	56.52'
2	CENTER OF STEEL RIGHT-OF-WAY POST	S59°12'W	64.37' 64.36
3	SET 3/4" IRON ROD (30" long)	S56°32'E	60.47' 60.17
4	SET 3/4" IRON ROD (30" long)	N56°47'E	59.35' 59.33

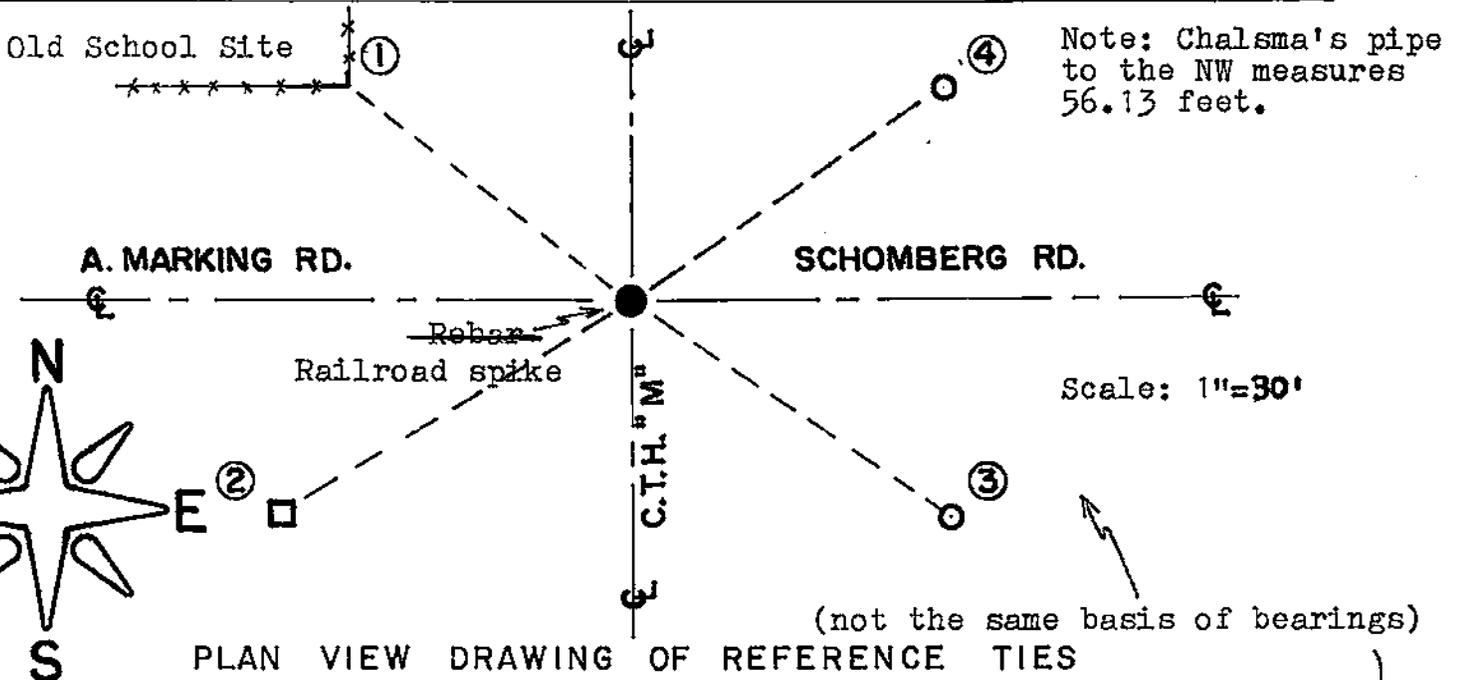

MAP SHOWING DISTANCE AND DIRECTION TO OTHER PUBLIC LAND SURVEY CORNERS USED FOR REESTABLISHING THE CORNER

(not to scale)

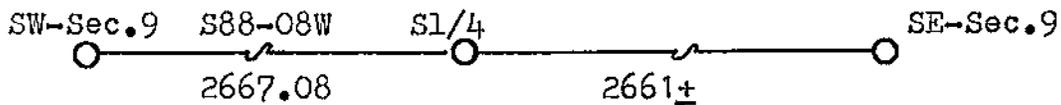

I, William C. Jung, Deputy County Surveyor,
 HEREBY CERTIFY THAT THE CORNER LOCATION SHOWN ON THIS RECORD
 WAS DETERMINED BY ME OR UNDER MY DIRECTION AND CONTROL AND
 THAT THIS U. S. PUBLIC LAND SURVEY MONUMENT RECORD IS CORRECT
 AND COMPLETE TO THE BEST OF MY KNOWLEDGE AND BELIEF.

William C. Jung
 Signature

3/14/86
 Date
 Revised: 12/29/92

W.C.J.

