


U. S. PUBLIC LAND SURVEY MONUMENT RECORD

SECTION 10 T 16 N, R 6 W, TOWN OF HAMILTON

LA CROSSE COUNTY

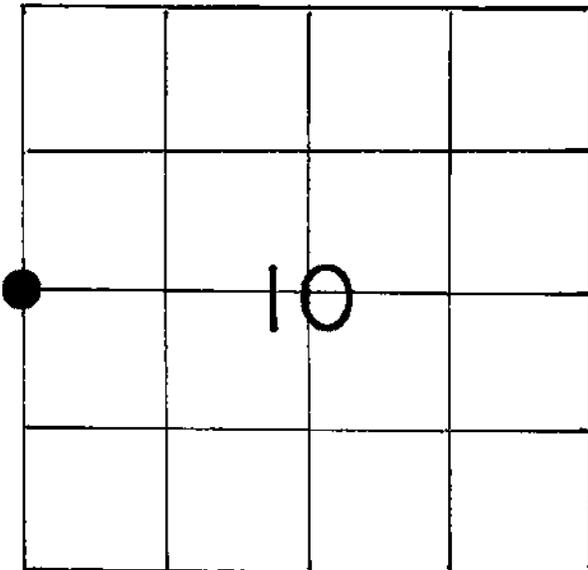

LOCATION OF LANDMARK

Crew: William Jung
 Perry Dahl
 10/2/84

Crew: William C. Jung
 Peter F. Follansbee
 7/2/92 and 9/25/92

WISCONSIN COORDINATE SYSTEM

North

East

Theta Angle

Horiz. Order

Vert. Order

TYPE OF LANDMARK

~~BERNTSEN~~ 1/2"x12" iron bar

BEARINGS ARE REFERENCED TO

Assumed

Describe any record evidence, monument evidence, testimonial evidence or any other material evidence you considered and whether the monument was found or restored through acceptance of an obliterated evidence location.

In November of 1979 I set a railroad spike at the occupied corner which I accepted as the best available evidence of the original government corner position. I found my railroad spike, removed it, and set a Berntsen marker, down 2". There are P.K. nails 1' East and 1' South of the corner.

***** (see below)

Describe or show any material discrepancy between the location of the restored corner and that of the corner previously restored or reestablished.


None known.

***** 1992 notes:

The Berntsen was partially destroyed during highway construction. The iron bar was set in the new pavement. Remnants of the old marker are still buried down in the subgrade.


RECORD OF DURABLE WITNESS MONUMENTS

| NO | DESCRIPTION | BEARING | DISTANCE |
|--------------|--|---------------------------|-------------------------|
| ok 1 | SET 1/2" IRON ROD | S50° 48' W | 41.85' |
| ok 2 | SET 1 1/4" IRON PIPE (27" long) | S 01° 13' 30" E | 24.75' |
| 3 | CENTER OF STREET SIGN POST | N66° 52' 30" E | 50.17' |
| 4 | SET 1 1/4" IRON PIPE (27" long) | NORTH ± | 24.75' 24.70 |

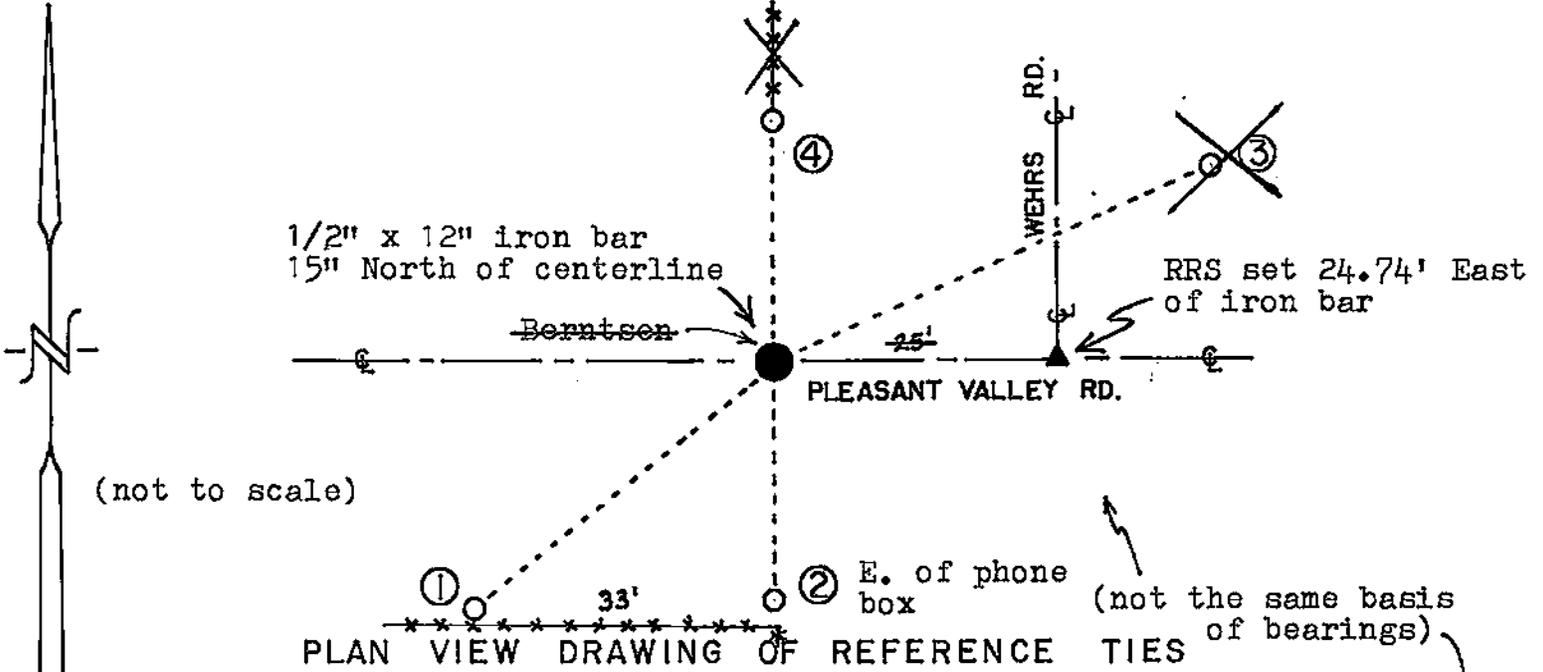

MAP SHOWING DISTANCE AND DIRECTION TO OTHER PUBLIC LAND SURVEY CORNERS USED FOR REESTABLISHING THE CORNER

(not to scale)

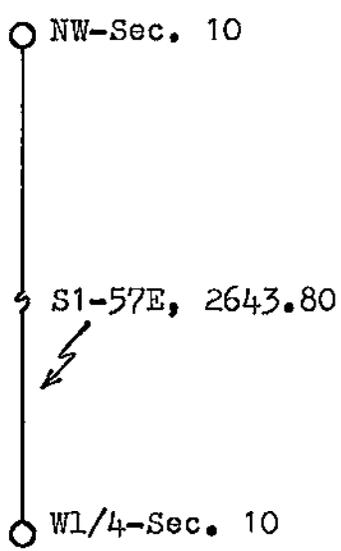

I, William C. Jung, Deputy County Surveyor,
HEREBY CERTIFY THAT THE CORNER LOCATION SHOWN ON THIS RECORD
WAS DETERMINED BY ME OR UNDER MY DIRECTION AND CONTROL AND
THAT THIS U. S. PUBLIC LAND SURVEY MONUMENT RECORD IS CORRECT
AND COMPLETE TO THE BEST OF MY KNOWLEDGE AND BELIEF.

William C. Jung
Signature

3/14/86
Date

Revised: 12/29/92
wclj

