


U. S. PUBLIC LAND SURVEY MONUMENT RECORD

SECTION 15 T 16 N, R 6 W, TOWN OF HAMILTON
LA CROSSE COUNTY

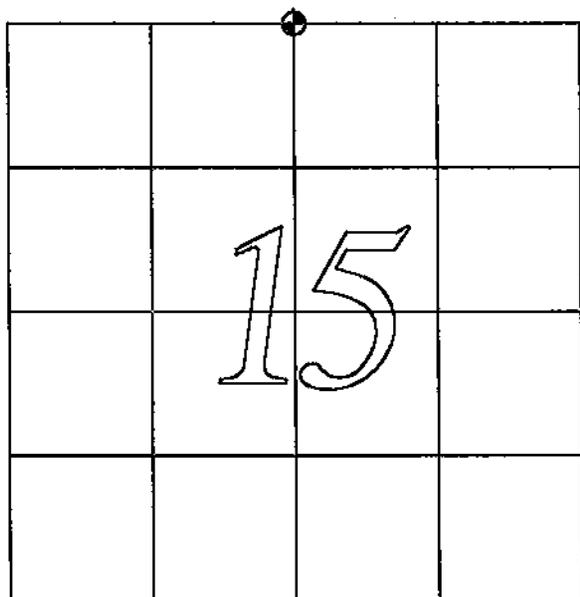

LOCATION OF LANDMARK

CREW: JOSH NAVE

DATE: 06/27/2003

Describe any record evidence, monument evidence, testimonial evidence, or any other material evidence you considered and whether the monument was found or restored through acceptance of an obliterated evidence location.

Evidence of original mound and pit not found. I set the corner at the base of an old wooden fence post with wire leading from the North and South terminating at said post.

Describe or show any material discrepancy between the location of the restored corner and that of the corner previously restored or reestablished.

NONE KNOWN.

WISCONSIN COORDINATE SYSTEM

North

East

Theta Angle

Horiz. Order

Vert. Order

TYPE OF LANDMARK

3/4" X 24" IRON BAR

BEARINGS ARE REFERENCED TO
 THE NORTH LINE OF THE NE 1/4,
 SECTION 15, T16N-R6W
 ASSUMED TO BEAR N 89°26'46" W

SEE TIE SHEET FOR THE NE CORNER
 OF SECTION 15

