


21606102000

U. S. PUBLIC LAND SURVEY MONUMENT RECORD

SECTION 11 T 16 N, R 6 W, TOWN OF Hamilton

LA CROSSE COUNTY

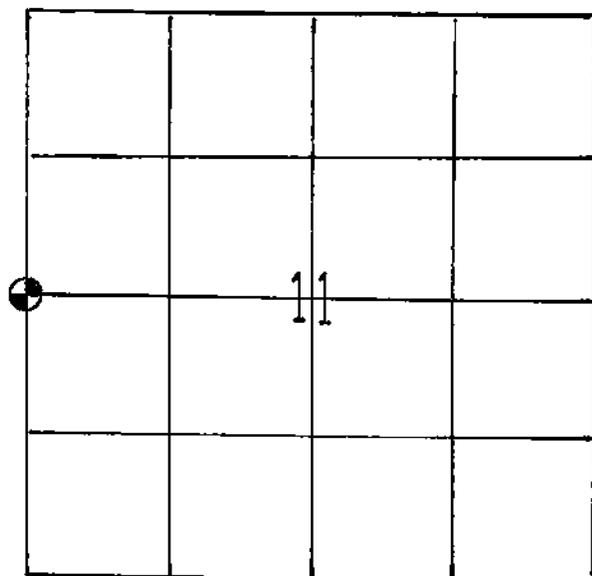

LOCATION OF LANDMARK

WISCONSIN COORDINATE SYSTEM
North
East
Theta Angle
Horiz. Order
Vert. Order
TYPE OF LANDMARK
Brass Capped Lunde Marker
BEARINGS ARE REFERENCED TO
True North (+2')

Crew: William C. Jung
Perry Dahl

1/13/87

Describe any record evidence, monument evidence, testimonial evidence or any other material evidence you considered and whether the monument was found or restored through acceptance of an obliterated evidence location.

I accepted an old four-way fence corner as the best available evidence of the original government corner position and monumented the occupied corner with a Lunde Marker.


Describe or show any material discrepancy between the location of the restored corner and that of the corner previously restored or reestablished.

None known.

RECORD OF DURABLE WITNESS MONUMENTS

NO	DESCRIPTION	BEARING	DISTANCE
1	P.K. in unblazed 4" elm	-----	5.20
2	P.K. in unblazed 4" box elder	-----	11.53
3	P.K. in unblazed 4" tree (ash?)	-----	17.85
4	P.K. in unblazed 4" elm	-----	2.68

(distances are to P.K. nails in hacks in unblazed bearing trees)

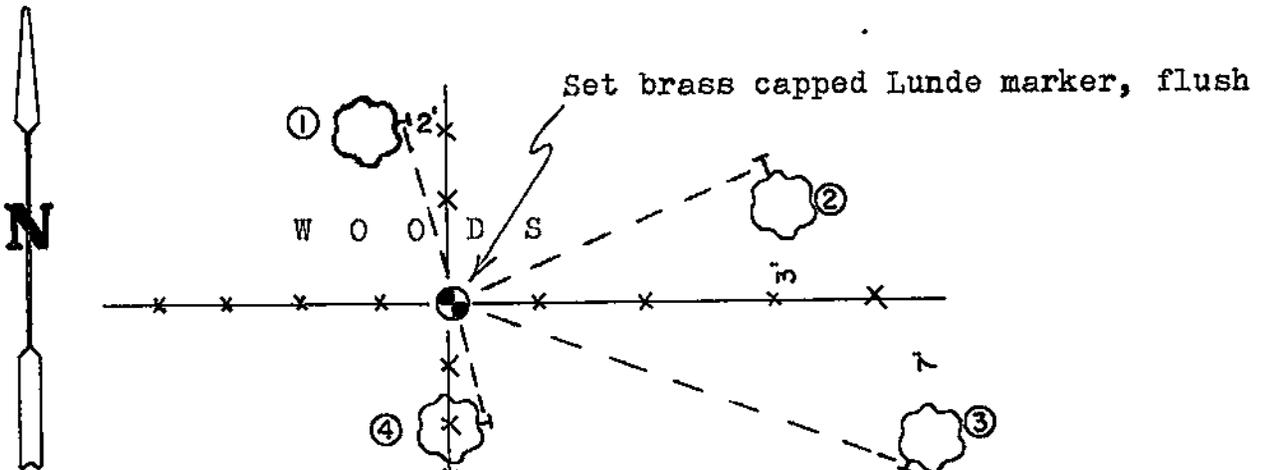


(all the fences are down or in disrepair)

PLAN VIEW DRAWING OF REFERENCE TIES

MAP SHOWING DISTANCE AND DIRECTION TO OTHER PUBLIC LAND SURVEY CORNERS USED FOR REESTABLISHING THE CORNER

(not to scale)

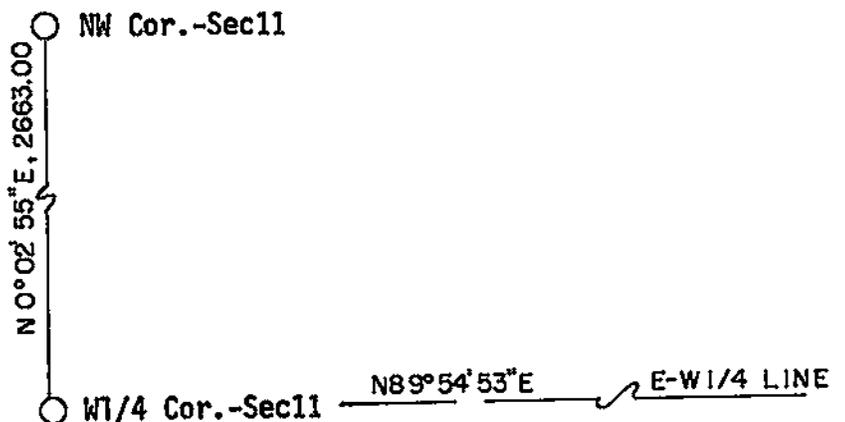

I, William C. Jung, Deputy County Surveyor,
 HEREBY CERTIFY THAT THE CORNER LOCATION SHOWN ON THIS RECORD
 WAS DETERMINED BY ME OR UNDER MY DIRECTION AND CONTROL AND
 THAT THIS U. S. PUBLIC LAND SURVEY MONUMENT RECORD IS CORRECT
 AND COMPLETE TO THE BEST OF MY KNOWLEDGE AND BELIEF.

William C. Jung January 16, 1987
 Signature Date

