


## U. S. PUBLIC LAND SURVEY MONUMENT RECORD

SECTION 11 T 16 N, R 6 W, TOWN OF Hamilton

LA CROSSE COUNTY

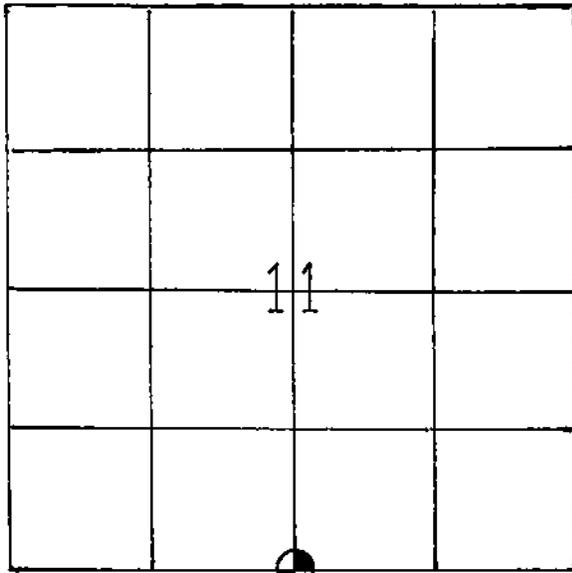

LOCATION OF LANDMARK

Crew: William C. Jung  
Perry Dahl

1/13/87

## WISCONSIN COORDINATE SYSTEM

North

East

Theta Angle

Horiz. Order

Vert. Order

## TYPE OF LANDMARK

1 $\frac{1}{4}$ " iron pipe

## BEARINGS ARE REFERENCED TO

True North ( $\pm 2'$ )

Describe any record evidence, monument evidence, testimonial evidence or any other material evidence you considered and whether the monument was found or restored through acceptance of an obliterated evidence location.


I accepted the old occupied corner as the best available evidence of the original government corner position and monumented the occupied corner with an iron pipe. Clayton Solberg apparently used this location as the corner in 1979 when he did a survey in the "forty" to the Southeast.

Describe or show any material discrepancy between the location of the restored corner and that of the corner previously restored or reestablished.

None known.

RECORD OF DURABLE WITNESS MONUMENTS


NO	DESCRIPTION	BEARING	DISTANCE
1	Set an iron pipe at the end of the fence	East $\pm$	37.57
2	Set an iron pipe in the old fence row	South $\pm$	142.80
3	Set a 1" round iron bar	South $\pm$	449.57
4			

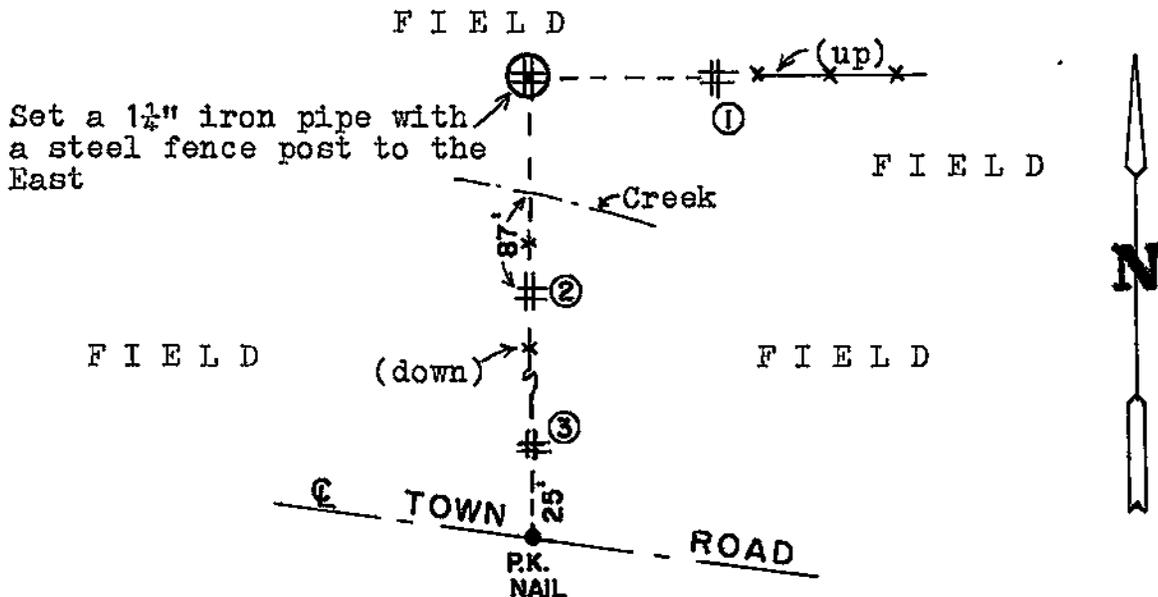

PLAN VIEW DRAWING OF REFERENCE TIES

MAP SHOWING DISTANCE AND DIRECTION TO OTHER PUBLIC LAND SURVEY CORNERS USED FOR REESTABLISHING THE CORNER


(not to scale)

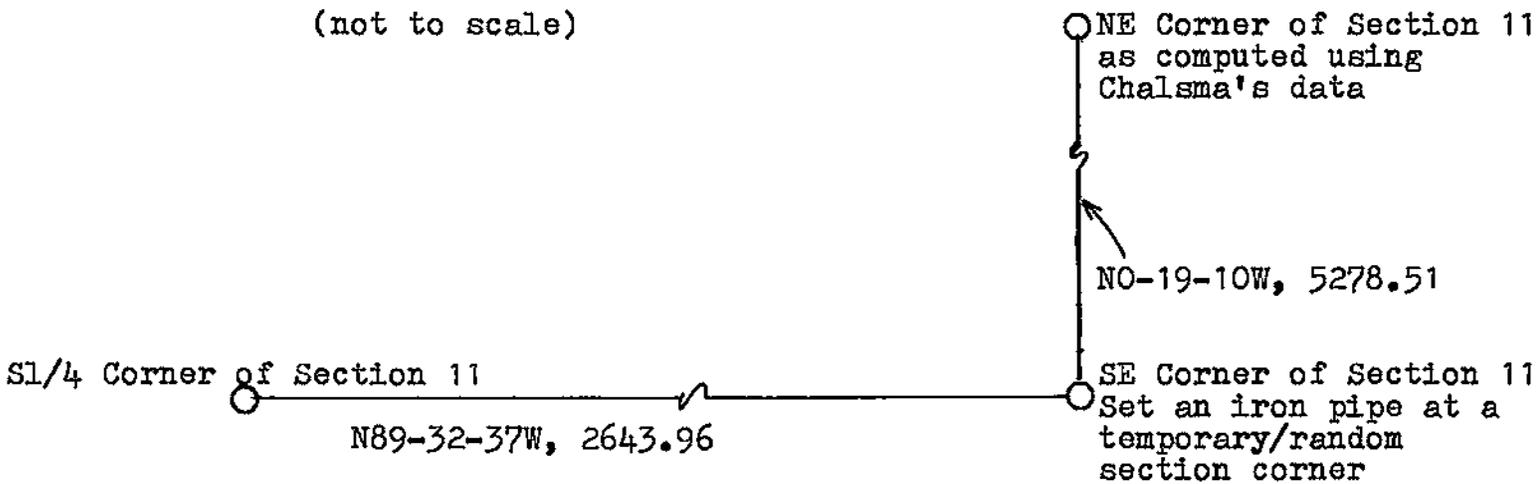

I, William C. Jung, Deputy County Surveyor,  
 HEREBY CERTIFY THAT THE CORNER LOCATION SHOWN ON THIS RECORD  
 WAS DETERMINED BY ME OR UNDER MY DIRECTION AND CONTROL AND  
 THAT THIS U. S. PUBLIC LAND SURVEY MONUMENT RECORD IS CORRECT  
 AND COMPLETE TO THE BEST OF MY KNOWLEDGE AND BELIEF.

William C. Jung  
 Signature

January 16, 1987  
 Date

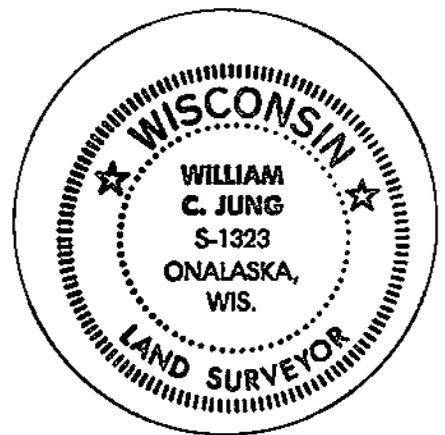

Seal