


21606112000

## U. S. PUBLIC LAND SURVEY MONUMENT RECORD

SECTION 11 T 16 N, R 6 W, TOWN OF HAMILTON

LA CROSSE COUNTY

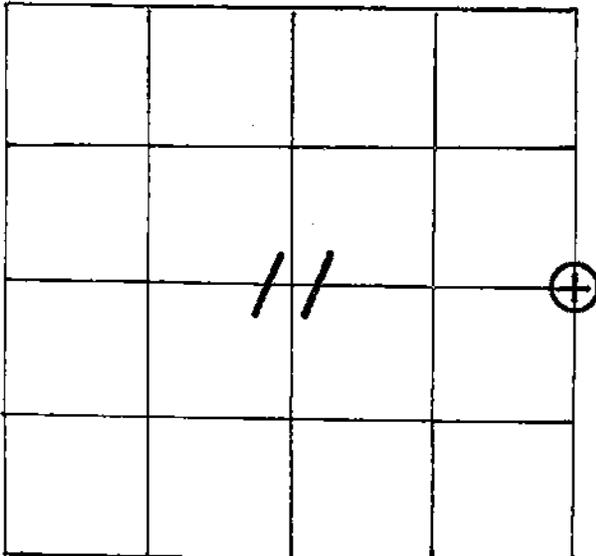

LOCATION OF LANDMARK

CREW: **WILLIAM C. JUNG**  
**PETER F. FOLLANSBEE**  
 DATE: **2/22/2005**

## WISCONSIN COORDINATE SYSTEM

North

East

Theta Angle

Horiz. Order

Vert. Order

## TYPE OF LANDMARK

*EX. IRON BAR WITH ALUMINUM CAP.*

BEARINGS ARE REFERENCED TO

Describe any record evidence, monument evidence, testimonial evidence or any other material evidence you considered and whether the monument was found or restored through acceptance of an obliterated evidence location.

Chris Fechner set an iron bar at this corner at the single proportionate position. We had discussed this corner at an earlier date. I agree with his decision on setting this corner. I found his bar, capped it, and tied it off.

Describe or show any material discrepancy between the location of the restored corner and that of the corner previously restored or reestablished.


**NONE KNOWN.**

RECORD OF DURABLE WITNESS MONUMENTS


MAGNETIC

NO	DESCRIPTION	BEARING	DISTANCE
1	SET A NAIL IN N.W.-SIDE OF A 12 1/2" HICKORY	S 70° W	20.00 FT.
2	SET A NAIL IN S.W.-SIDE OF AN 8 1/4" ELM	N 36° W	21.64 FT.
3	SET A NAIL IN S.-SIDE OF A 9 1/2" BOX ELDER	S 88° E	27.38 FT.
4	SET A NAIL IN S.W.-SIDE OF A 10" BOX ELDER	S 21° E	9.04 FT.

(NOT TO SCALE)

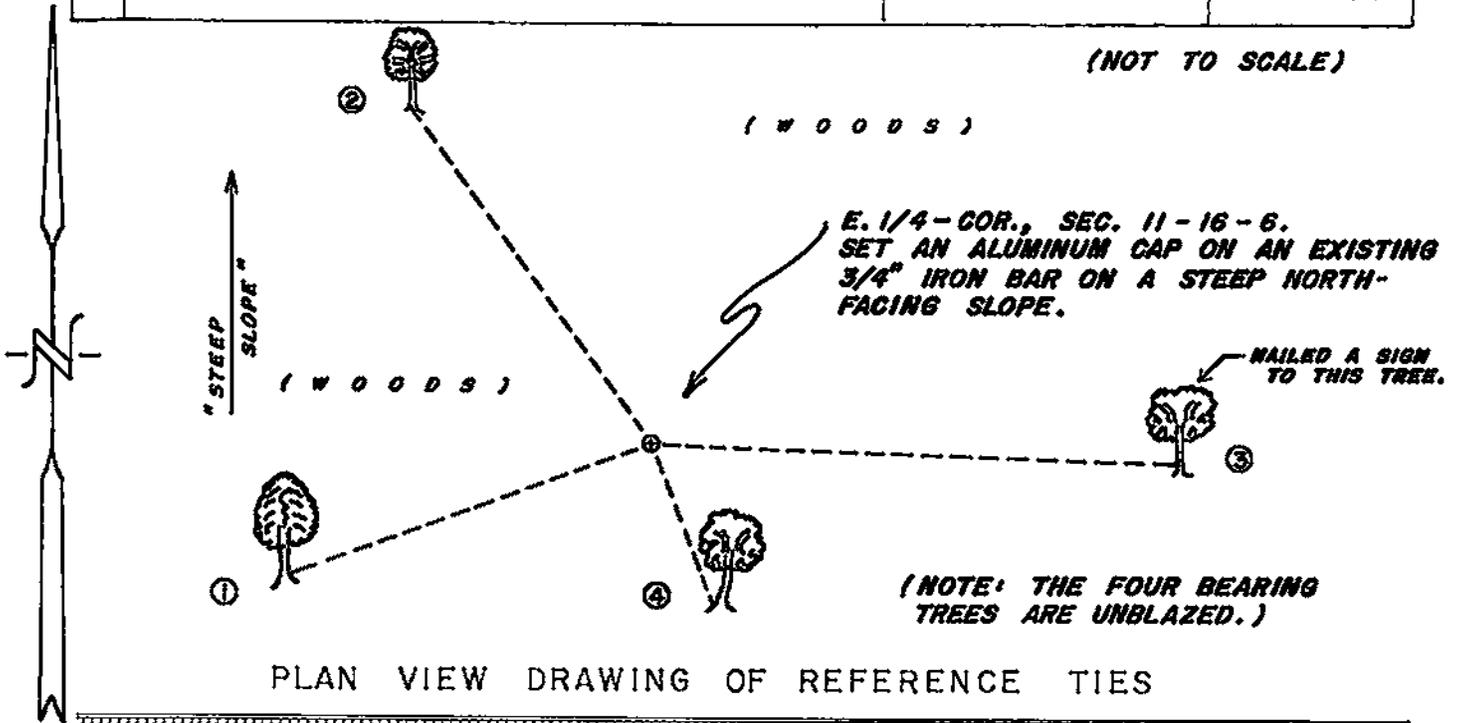

MAP SHOWING DISTANCE AND DIRECTION TO OTHER PUBLIC LAND SURVEY CORNERS USED FOR REESTABLISHING THE CORNER

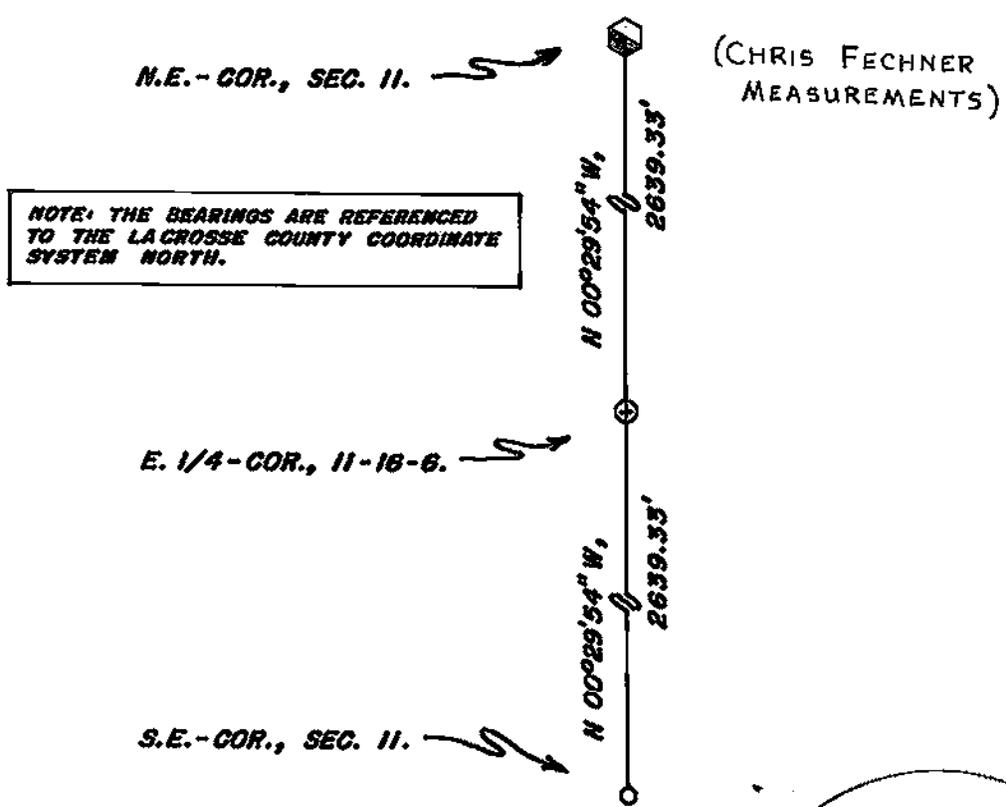

I, WILLIAM C. JUNG, COUNTY SURVEYOR  
HEREBY CERTIFY THAT THE CORNER LOCATION SHOWN ON THIS RECORD WAS DETERMINED BY ME OR UNDER MY DIRECTION AND CONTROL AND THAT THIS U. S. PUBLIC LAND SURVEY MONUMENT RECORD IS CORRECT AND COMPLETE TO THE BEST OF MY KNOWLEDGE AND BELIEF.

William C. Jung 5/9/06  
Signature Date



Seal