


U. S. PUBLIC LAND SURVEY MONUMENT RECORD

SECTION 12 T 16 N, R 6 W, TOWN OF HAMILTON
LA CROSSE COUNTY

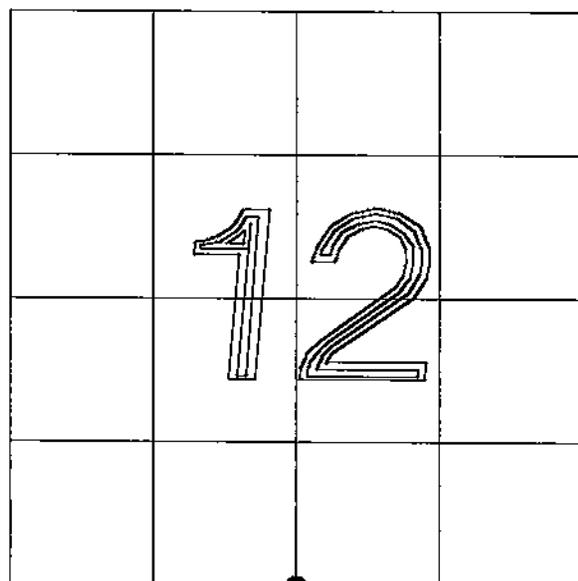

LOCATION OF LANDMARK

WISCONSIN COORDINATE SYSTEM
North
East
Theta Angle
Horiz. Order
Vert. Order
TYPE OF LANDMARK
3/4" X 30" IRON BAR
BEARINGS ARE REFERENCED TO
TRUE NORTH

CREW: CHRIS FECHNER

JEFF FECHNER JOSH NAVE

DATE: 07/28/00

Describe any record evidence, monument evidence, testimonial evidence, or any other material evidence you considered and whether the monument was found or restored through acceptance of an obliterated evidence location.


Parole testimony by Greg Edge, LaCrosse County Forester, indicated that his predecessor set an aluminum monument at a wood stake placed by Fred Kraft. I believe this was a survey point and not the corner. It does not compute with Kraft's retracement survey. I have set a 3/4" X 30" iron bar at Kraft's computed location, per his 1979 survey for the Coulee Experimental Forest.

Describe or show any material discrepancy between the location of the restored corner and that of the corner previously restored or reestablished.


The found aluminum monument does not fit Fred Kraft's retracement. The irons he set on the South line of the SE 1/4 of Section 12 fit very well with his recorded information. His dimensions from the fence intersections to the true corner location fit very well with the existing structures.

RECORD OF DURABLE WITNESS MONUMENTS

NO	DESCRIPTION	BEARING	DISTANCE
1	5" Diameter Aluminum monument	N 42° E	11.4 ft
2	Set P.K. nail in single blazed 20" American Elm	S 33° E	37.9 ft
3	Set P.K. nail in single blazed 14" American Elm	S 25° W	24.0 ft
4	Set P.K. nail in single blazed 14" Oak	N 35° W	33.9 ft

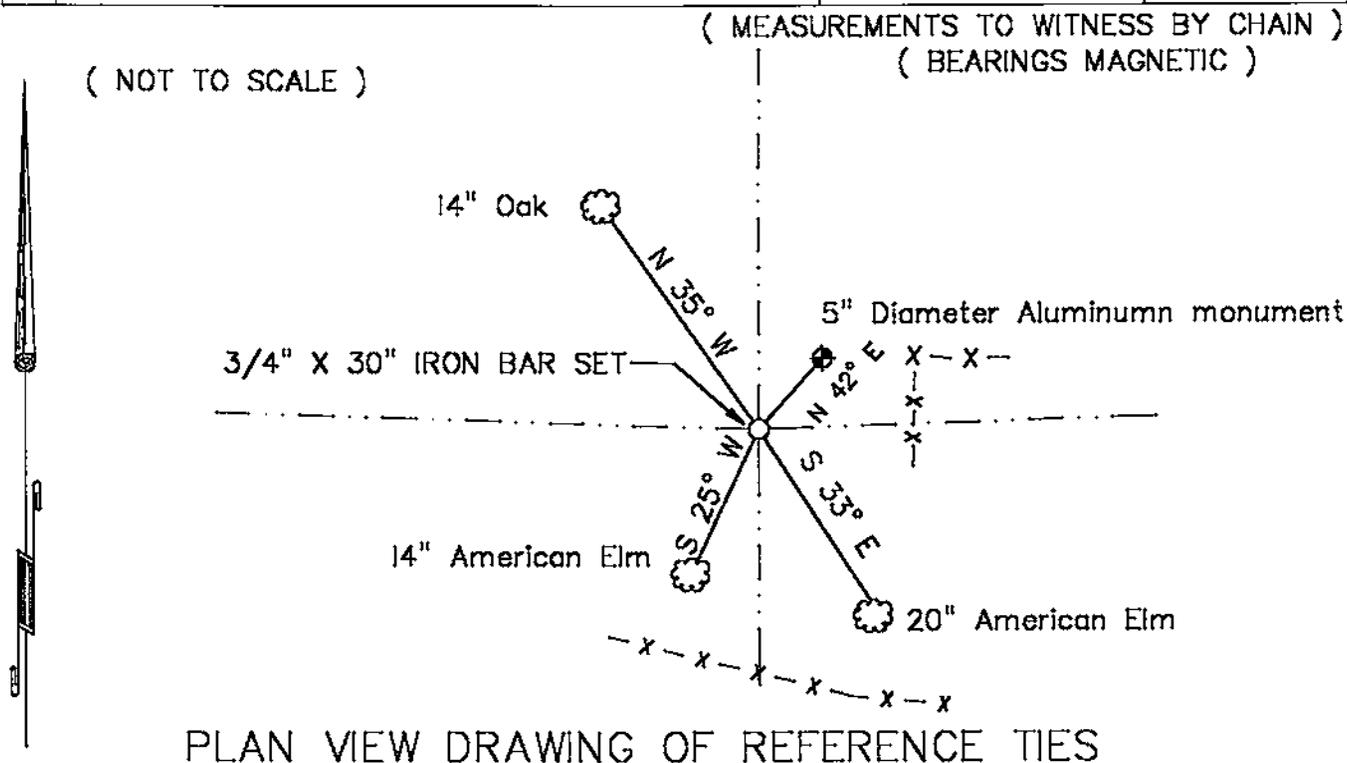

MAP SHOWING DISTANCE AND DIRECTION TO OTHER PUBLIC LAND SURVEY CORNERS USED FOR REESTABLISHING THE CORNER

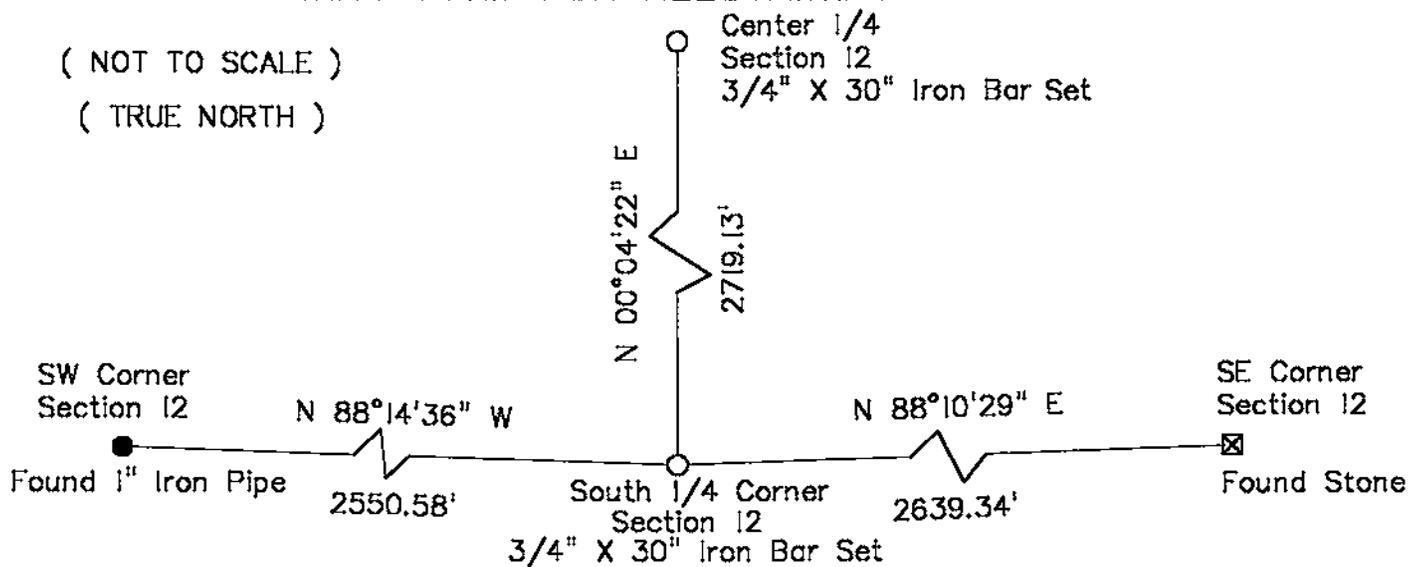

I, CHRISTOPHER W. FECHNER

HEREBY CERTIFY THAT THE CORNER LOCATION SHOWN ON THIS RECORD WAS DETERMINED BY ME OR UNDER MY DIRECTION AND CONTROL AND THAT THIS U. S. PUBLIC LAND SURVEY MONUMENT RECORD IS CORRECT AND COMPLETE TO THE BEST OF MY KNOWLEDGE AND BELIEF.



Christopher W. Fechner

Signature

10/17/00

Date

Seal

SE - SW

Perole testimony from Greg Edges, the LaCrosse County Forester, indicated that his predecessor set this Aluminum Monument at a wood stake placed by Fred Kraft. I believe this was a survey point and not the corner. It does not compute with Kraft's retracement survey. I have set a 3/4" Iron Bar at Kraft's computed location.

P.O.B.

N 88°14'36" W
1275.29'

S 1/4 CORNER, SECTION 12

ALUM. MON TO SET IB
S 38°50'48" W 11.09'

S 00°04'22" W

1359.565'

2

5.29'

3

COULLEN

CONFIDENTIAL

ION:
STEM