


21606140000

## U. S. PUBLIC LAND SURVEY MONUMENT RECORD

SECTION 23 T 16 N, R 6 W, TOWN OF BARRE

LA CROSSE COUNTY

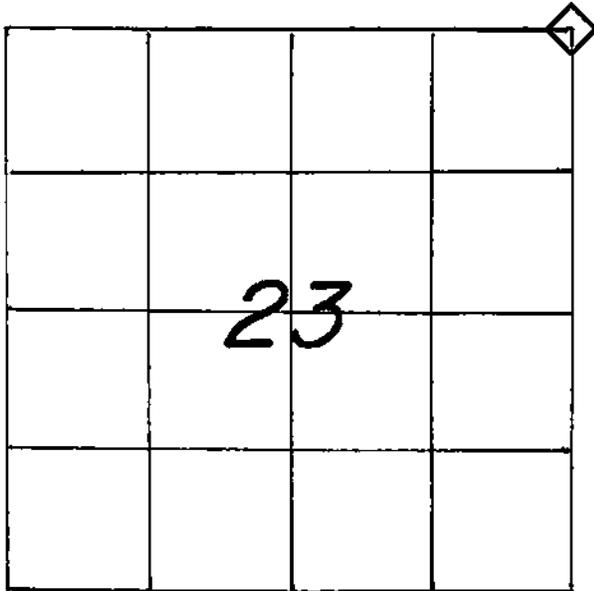

LOCATION OF LANDMARK

## WISCONSIN COORDINATE SYSTEM

North

East

Theta Angle

Horiz. Order

Vert. Order

## TYPE OF LANDMARK

Existing 6" square Stone.

## BEARINGS ARE REFERENCED TO

True North

Crew: WILLIAM C. JUNG  
 PETER F. FOLLANSBEE  
 Date: 3/29/1996

Describe any record evidence, monument evidence, testimonial evidence or any other material evidence you considered and whether the monument was found or restored through acceptance of an obliterated evidence location.

We found a stone at the corner and accepted it as the best available evidence of the original government corner position.


Describe or show any material discrepancy between the location of the restored corner and that of the corner previously restored or reestablished.

None Known.

RECORD OF DURABLE WITNESS MONUMENTS


NO	DESCRIPTION	MAGNETIC	
		BEARING	DISTANCE
1	Set P.K. Nail in SE-side 5" Hickory	N 15°E	16.17 Ft.
2	Set P.K. Nail in NW-side 5½" Hickory	N 45°E	31.33 Ft.
3	Set P.K. Nail in NE-side 5½" Hickory	S 74°E	23.53 Ft.
4	Set P.K. Nail in SW-side 7½" Burr Oak	S 14°E	21.50 Ft.

NE-Cor., Sec. 23-16-6.  
Existing 6" square Stone with an "X" in the top. The Stone is up 6"s and 5'± north of a downed fence. Set a sign post on the west side of the Stone.

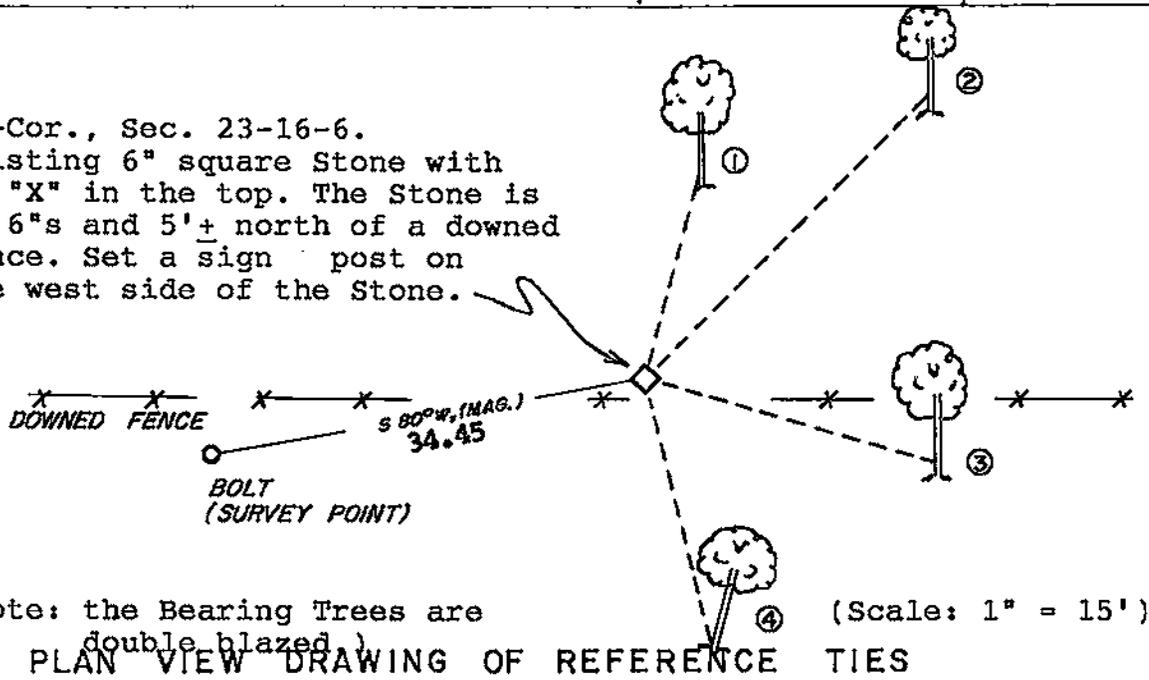

MAP SHOWING DISTANCE AND DIRECTION TO OTHER PUBLIC LAND SURVEY CORNERS USED FOR REESTABLISHING THE CORNER

(not to scale)

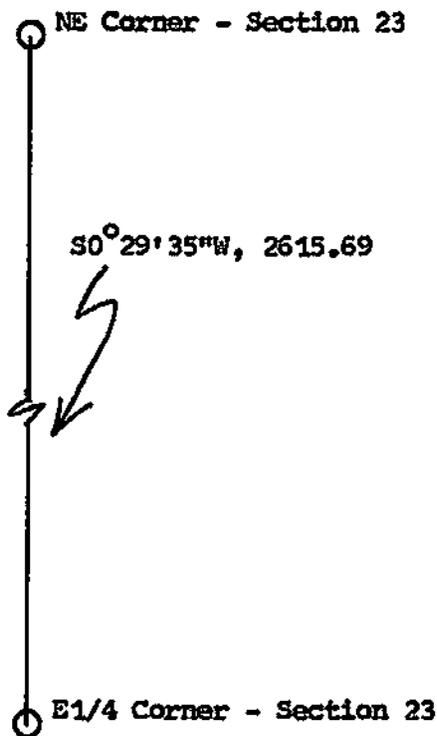

I, William C. Jung, County Surveyor  
HEREBY CERTIFY THAT THE CORNER LOCATION SHOWN ON THIS RECORD WAS DETERMINED BY ME OR UNDER MY DIRECTION AND CONTROL AND THAT THIS U. S. PUBLIC LAND SURVEY MONUMENT RECORD IS CORRECT AND COMPLETE TO THE BEST OF MY KNOWLEDGE AND BELIEF.

William C. Jung 6/3/96  
Signature Date



Seal