


21606140020

## U. S. PUBLIC LAND SURVEY MONUMENT RECORD

SECTION 23 T 16 N, R 6 W, TOWN OF BARRE

LA CROSSE COUNTY

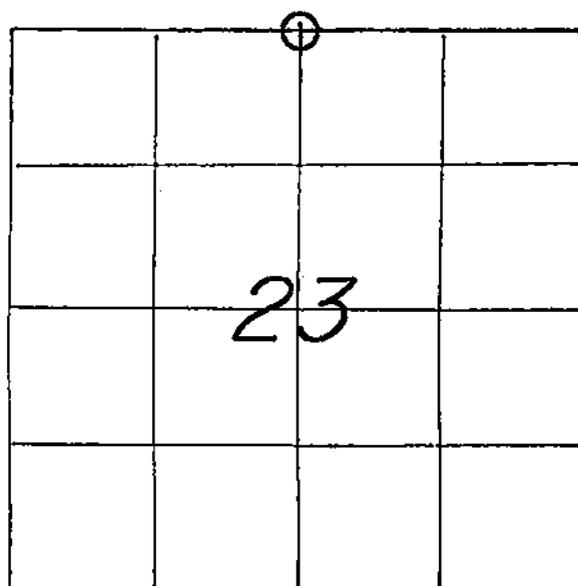

LOCATION OF LANDMARK

CREW: *WILLIAM C. JUNG*  
*PETER F. FOLLANSBEE*  
 DATE: *5/28/1998*

WISCONSIN COORDINATE SYSTEM

North

East

Theta Angle

Horiz. Order

Vert. Order

TYPE OF LANDMARK

*3/4" x 30" IRON BAR WITH ALUMINUM CAP.*

BEARINGS ARE REFERENCED TO

Describe any record evidence, monument evidence, testimonial evidence or any other material evidence you considered and whether the monument was found or restored through acceptance of an obliterated evidence location.

This corner was set at a point where the N-S1/4 line that I established in 1996 intersects the final section line that Maxwell and I agreed on. It is 3.37 feet South of the pipe that I set as a temporary corner in 1996. We searched extensively for a stone but found nothing.

Describe or show any material discrepancy between the location of the restored corner and that of the corner previously restored or reestablished.


**NONE KNOWN.**

RECORD OF DURABLE WITNESS MONUMENTS  
MAGNETIC

NO	DESCRIPTION	BEARING	DISTANCE
1	NAIL IN S-SIDE 44" BASSWOOD	N 73° W	44.55 FT.
2	NAIL IN S.W.-SIDE 31" WHITE OAK	N 44° W	SL. = 71.88'
3	NAIL IN N.-SIDE OF AN APPLE TREE	N 64° E	45.05 FT.
4	NAIL IN N.W.-SIDE OF A FOUR TRUNK ELM	S 25° E	SL. = 92.75'

( NOT TO SCALE )

( NOTE: THE BEARING TREES ARE UNBLAZED EXCEPT FOR ONE OF THE FOUR TRUNKS OF THE ELM, WHICH IS DOUBLE BLAZED. )

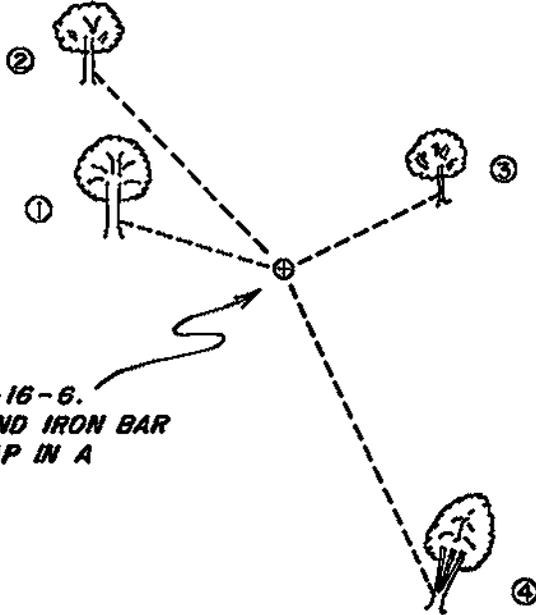

N. 1/4 - COR., SEC. 23-16-6.  
SET A 3/4" x 30" ROUND IRON BAR  
WITH AN ALUMINUM CAP IN A  
MOUND OF ROCKS.

PLAN VIEW DRAWING OF REFERENCE TIES

MAP SHOWING DISTANCE AND DIRECTION TO OTHER PUBLIC LAND SURVEY CORNERS USED FOR REESTABLISHING THE CORNER

of the pipe

This point is 3.37 feet South on the 1/4 line that I established in 1996.

Refer to that section data sheet.

I, WILLIAM C. JUNG, COUNTY SURVEYOR  
HEREBY CERTIFY THAT THE CORNER LOCATION SHOWN ON THIS RECORD  
WAS DETERMINED BY ME OR UNDER MY DIRECTION AND CONTROL AND  
THAT THIS U. S. PUBLIC LAND SURVEY MONUMENT RECORD IS CORRECT  
AND COMPLETE TO THE BEST OF MY KNOWLEDGE AND BELIEF.

William C. Jung 4/20/99  
Signature Date



Seal