


21606152000

U. S. PUBLIC LAND SURVEY MONUMENT RECORD

SECTION 15 T 16 N, R 6 W, TOWN OF HAMILTON/BARRE
LA CROSSE COUNTY

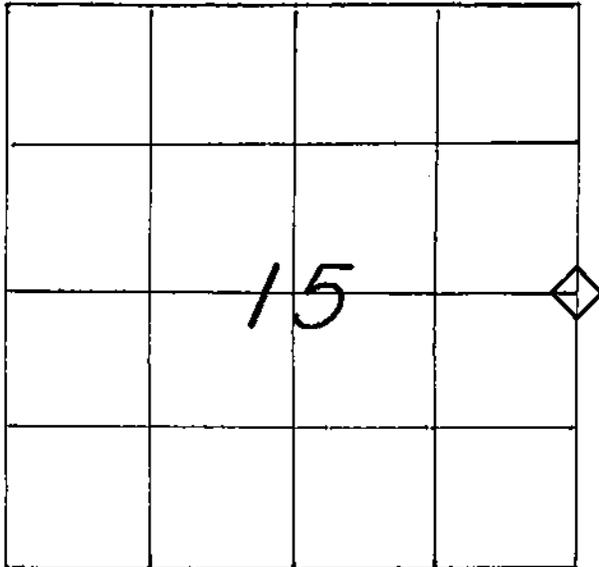

LOCATION OF LANDMARK

CREW: *WILLIAM C. JUNG*
PETER F. FOLLANSBEE
DATE: *5/27/1998*

WISCONSIN COORDINATE SYSTEM

North

East

Theta Angle

Horiz. Order

Vert. Order

TYPE OF LANDMARK

6" SQUARE STONE WITH CROSS.

BEARINGS ARE REFERENCED TO

Describe any record evidence, monument evidence, testimonial evidence or any other material evidence you considered and whether the monument was found or restored through acceptance of an obliterated evidence location.

I found a 6" square stone with a cross, buried in a field, and tied it off.

I accepted the stone as the best available evidence of the original government corner position.


Describe or show any material discrepancy between the location of the restored corner and that of the corner previously restored or reestablished.

None known.

RECORD OF DURABLE WITNESS MONUMENTS
MAGNETIC

NO	DESCRIPTION	BEARING	DISTANCE
1	NAIL IN E-SIDE OF AN 11" CHERRY 4 FT. N. OF FENCE	N 02° E	36.09 FT.
2	NAIL IN S.E.-SIDE OF A 28" BURR OAK	N 08° E	51.50 FT.
3	NAIL IN S.E.-SIDE 34" BURR OAK 8' N. OF FENCE	N 15° E	41.67 FT.
4	NAIL IN N.E.-SIDE 7" CHERRY	S 80° E	32.80 FT.

(NOTE: THE TWO CHERRY TREES ARE DOUBLE BLAZED AND THE TWO BURR OAKS ARE UNBLAZED)

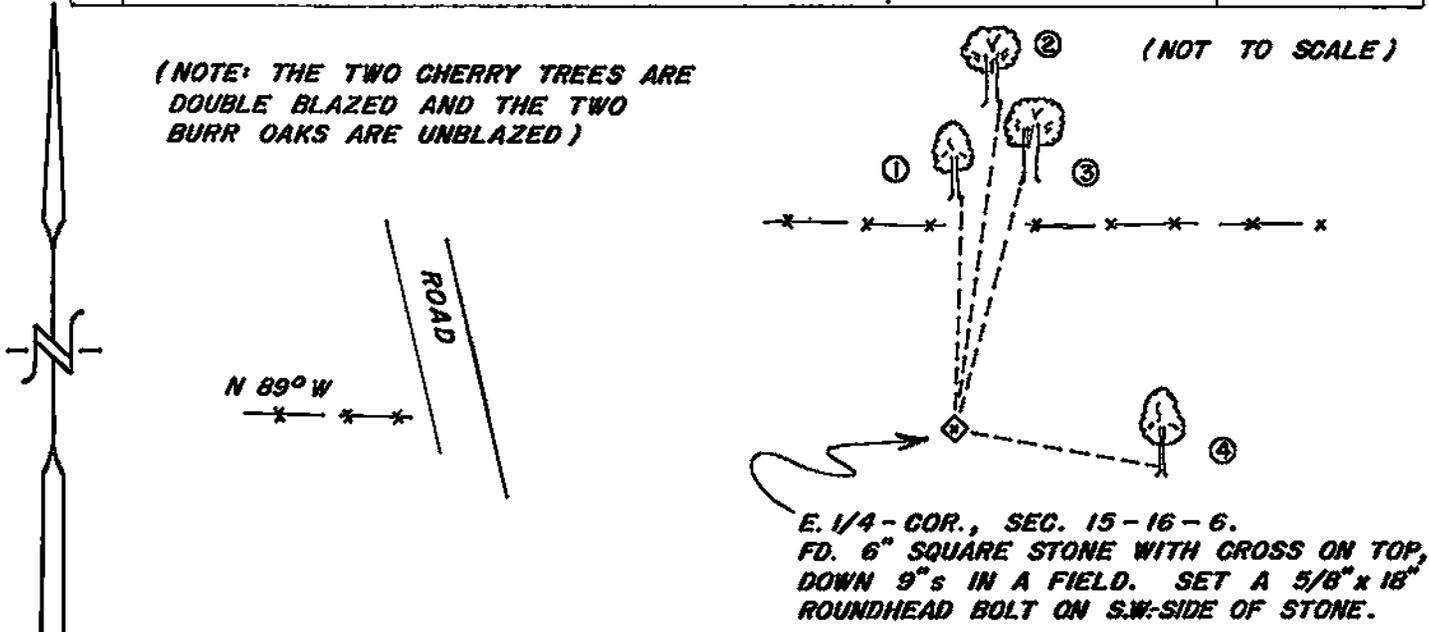

E. 1/4 - COR., SEC. 15-16-6.
FD. 6" SQUARE STONE WITH CROSS ON TOP,
DOWN 9" IN A FIELD. SET A 5/8" x 18"
ROUNDHEAD BOLT ON S.W.-SIDE OF STONE.


PLAN VIEW DRAWING OF REFERENCE TIES

MAP SHOWING DISTANCE AND DIRECTION TO OTHER PUBLIC LAND SURVEY CORNERS USED FOR REESTABLISHING THE CORNER

No section measurements were made by me at this time.

I, WILLIAM C. JUNG, COUNTY SURVEYOR
HEREBY CERTIFY THAT THE CORNER LOCATION SHOWN ON THIS RECORD
WAS DETERMINED BY ME OR UNDER MY DIRECTION AND CONTROL AND
THAT THIS U. S. PUBLIC LAND SURVEY MONUMENT RECORD IS CORRECT
AND COMPLETE TO THE BEST OF MY KNOWLEDGE AND BELIEF.

William C. Jung 2/24/99
Signature Date

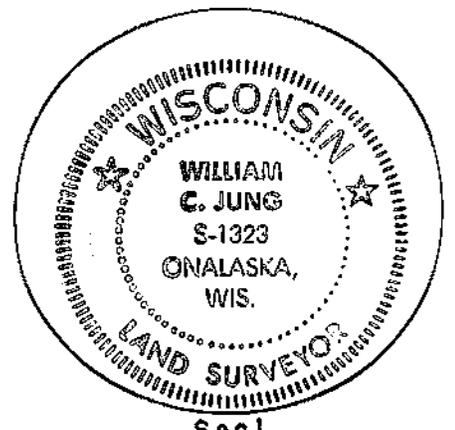

Seal