


21606160000

U. S. PUBLIC LAND SURVEY MONUMENT RECORD

SECTION 22 T 16 N, R 6 W, TOWN OF BARRE

LA CROSSE COUNTY

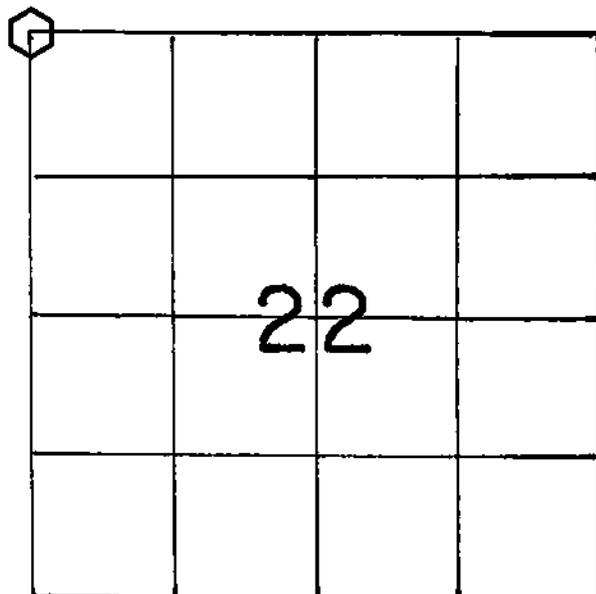

LOCATION OF LANDMARK

WISCONSIN COORDINATE SYSTEM

North

East

Theta Angle

Horiz. Order

Vert. Order

TYPE OF LANDMARK

Brass cap Lunde marker.

BEARINGS ARE REFERENCED TO

True North

Crew: WILLIAM C. JUNG

Date: 6/03/1993

Describe any record evidence, monument evidence, testimonial evidence or any other material evidence you considered and whether the monument was found or restored through acceptance of an obliterated evidence location.

Derald Kading shows an existing iron pipe at this corner in April of 1979. Ray Pelishek calls for a County Survey Marker at this corner in October of 1979. I found a Berntsen marker at the corner. It fits the occupied conditions very well. The Berntsen had been "heaved up" by frost and hit by a snowplow. I replaced the Berntsen with a brass capped Lunde marker.


Describe or show any material discrepancy between the location of the restored corner and that of the corner previously restored or reestablished.

(None Known)

U. S. PUBLIC LAND SURVEY MONUMENT RECORD

SECTION 22 T 16 N, R 6 W, TOWN OF BARRE

LA CROSSE COUNTY

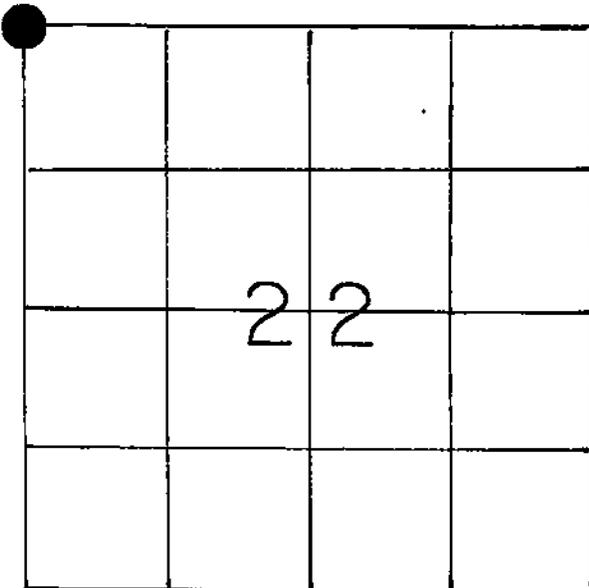

LOCATION OF LANDMARK

Crew: William Jung
Peter Follansbee

8/10/1987

Describe any record evidence, monument evidence, testimonial evidence or any other material evidence you considered and whether the monument was found or restored through acceptance of an obliterated evidence location.

Derald Kading shows an existing iron pipe at this corner in April of 1979. Ray Pelishek calls for a County Survey Marker at this corner in October of 1979. I found a Berntsen marker at the corner. It fits the occupied conditions very well.

Describe or show any material discrepancy between the location of the restored corner and that of the corner previously restored or reestablished.


(NONE KNOWN)

WISCONSIN COORDINATE SYSTEM
North
East
Theta Angle
Horiz. Order
Vert. Order
TYPE OF LANDMARK
BERNTSEN
BEARINGS ARE REFERENCED TO
TRUE NORTH

VOID

RECORD OF DURABLE WITNESS MONUMENTS


NO	DESCRIPTION	BEARING	DISTANCE
1	EXIST. IRON PIPE INSIDE A 2" IRON PIPE	SOUTH ±	33.00 Ft.
2	NORTHWEST CORNER OF WESTERLY CULVERT WALL	S 30 E ±	19.00 Ft.
3	NORTHWEST CORNER OF EASTERLY CULVERT WALL	S 60 E ±	37.29 Ft.
4	NORTHEAST CORNER OF EXISTING HOUSE	S 40 E ±	128.67 Ft.

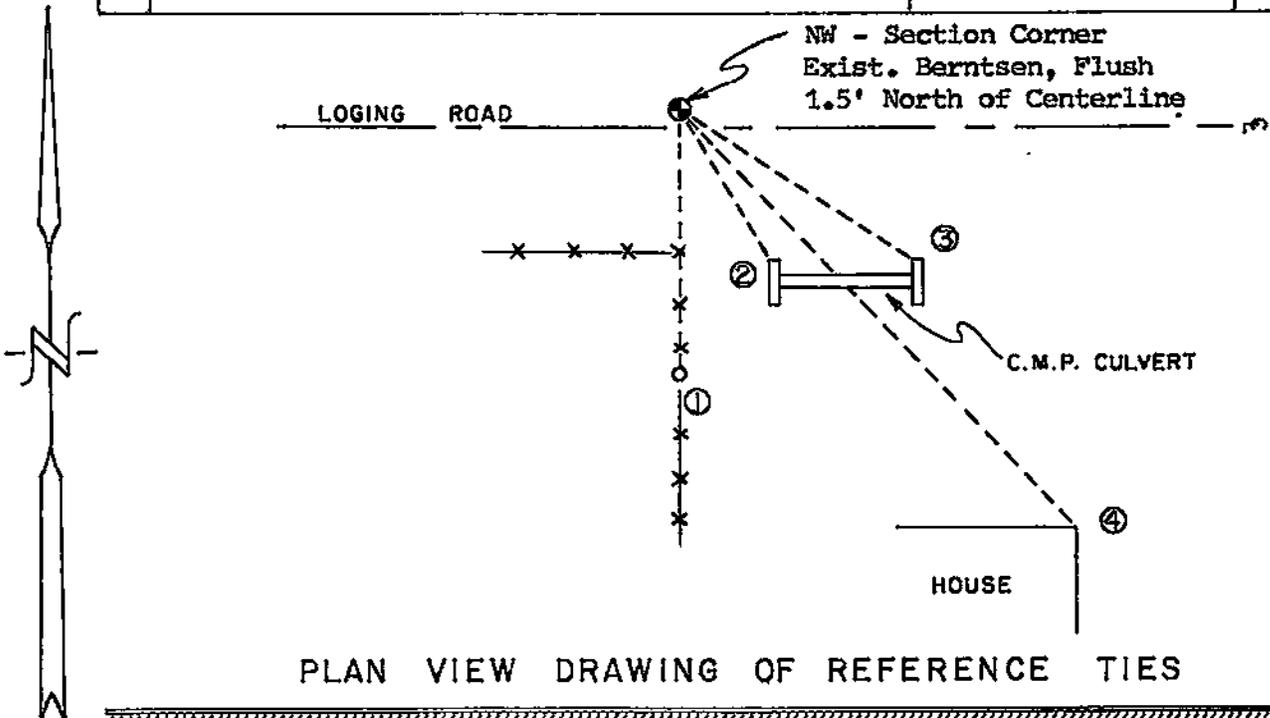

PLAN VIEW DRAWING OF REFERENCE TIES

MAP SHOWING DISTANCE AND DIRECTION TO OTHER PUBLIC LAND SURVEY CORNERS USED FOR REESTABLISHING THE CORNER

(NOT TO SCALE)

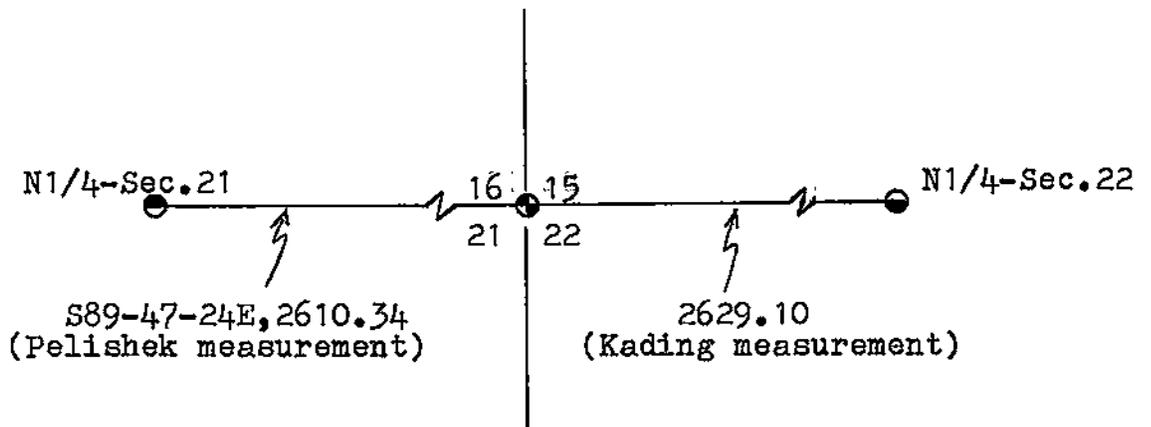

I, WILLIAM C. JUNG
 HEREBY CERTIFY THAT THE CORNER LOCATION SHOWN ON THIS RECORD
 WAS DETERMINED BY ME OR UNDER MY DIRECTION AND CONTROL AND
 THAT THIS U. S. PUBLIC LAND SURVEY MONUMENT RECORD IS CORRECT
 AND COMPLETE TO THE BEST OF MY KNOWLEDGE AND BELIEF.

William C. Jung December 18, 1987
 Signature Deputy County Surveyor Date



Seal