


21606162000

## U. S. PUBLIC LAND SURVEY MONUMENT RECORD

SECTION 15 T 16 N, R 6 W, TOWN OF HAMILTON/BARRE  
 LA CROSSE COUNTY

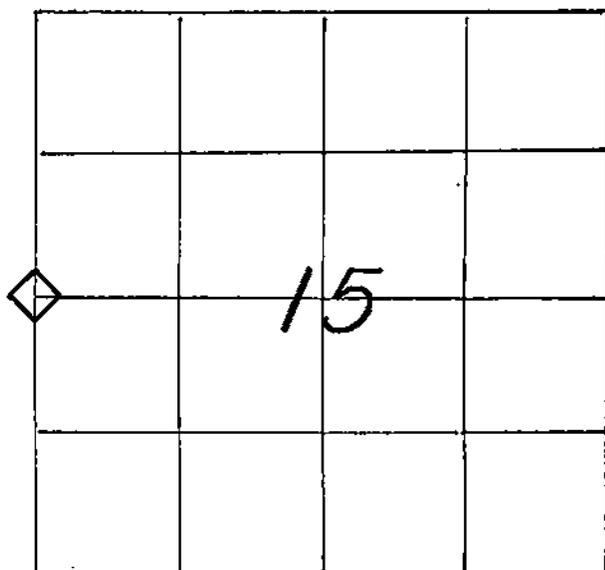

WISCONSIN COORDINATE SYSTEM

North

East

Theta Angle

Horiz. Order

Vert. Order

TYPE OF LANDMARK

**6" SQUARE STONE WITH CROSS.**

BEARINGS ARE REFERENCED TO

LOCATION OF LANDMARK

CREW: **WILLIAM C. JUNG****PETER F. FOLLANSBEE**DATE: **5/27/1998**

Describe any record evidence, monument evidence, testimonial evidence or any other material evidence you considered and whether the monument was found or restored through acceptance of an obliterated evidence location.


I found a 6" square stone with a cross scribed "1/4S", plumbed it up, and tied it off. I accepted the stone as the best available evidence of the original government corner position.

Describe or show any material discrepancy between the location of the restored corner and that of the corner previously restored or reestablished.

None known.

RECORD OF DURABLE WITNESS MONUMENTS

| NO | DESCRIPTION   | BEARING       | DISTANCE  |
|----|---|---------------|-----------|
| 1  | SET A 1-1/4" x 18" IRON PIPE UNDER THE FENCE              | NORTH ±       | 33.17 FT. |
| 2  | SET A 5/8" x 26" REBAR IN THE PASTURE                     | N. EASTERLY ± | 33.39 FT. |
| 3  | SET A 1-1/4" x 14" IRON PIPE ON N-SIDE OF FENCE           | EAST ±        | 33.90 FT. |
| 4  | SET A NAIL UP 1 FT. IN N-SIDE OF A 9" CEDAR<br>(unblazed) | EAST ±        | 96.50 FT. |

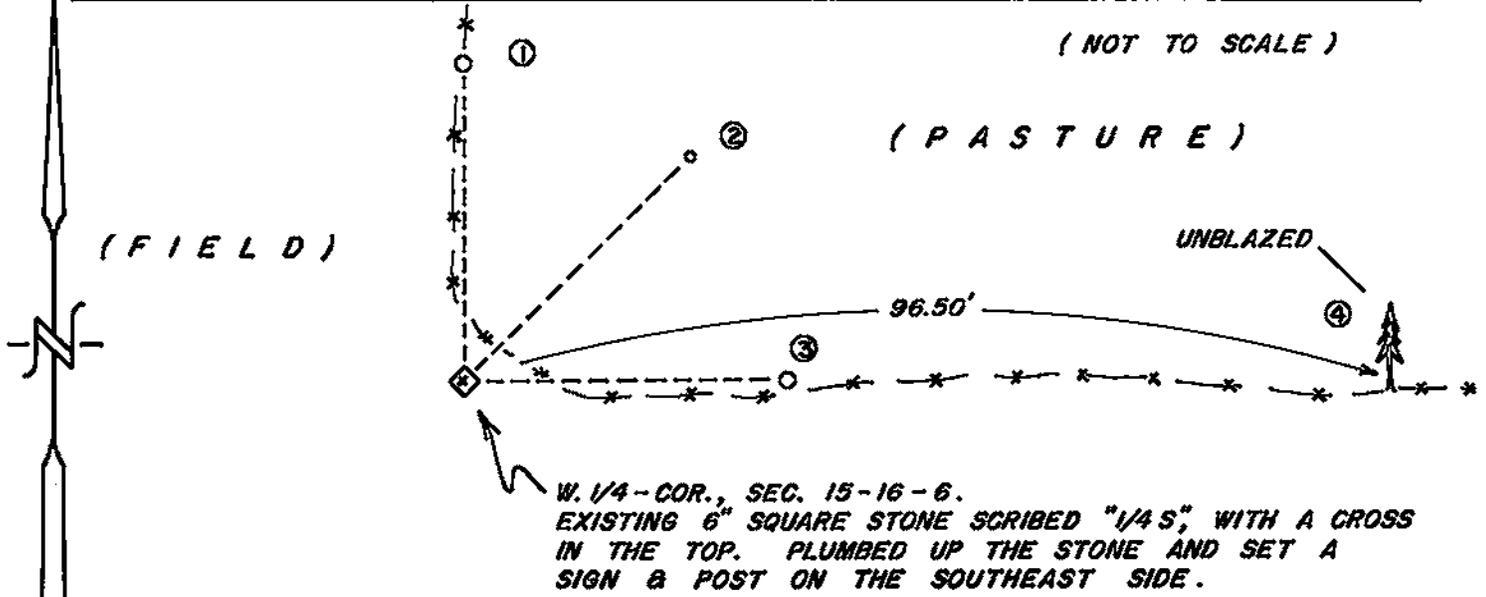

PLAN VIEW DRAWING OF REFERENCE TIES

MAP SHOWING DISTANCE AND DIRECTION TO OTHER PUBLIC LAND SURVEY CORNERS USED FOR REESTABLISHING THE CORNER

No section measurements were made by me at this time.

I, WILLIAM C. JUNG, COUNTY SURVEYOR  
HEREBY CERTIFY THAT THE CORNER LOCATION SHOWN ON THIS RECORD  
WAS DETERMINED BY ME OR UNDER MY DIRECTION AND CONTROL AND  
THAT THIS U. S. PUBLIC LAND SURVEY MONUMENT RECORD IS CORRECT  
AND COMPLETE TO THE BEST OF MY KNOWLEDGE AND BELIEF.

William C. Jung                      2/24/99  
Signature                                      Date



Seal