

Tie sheet Update – 21606180020 (La Crosse County Index 90E)

John Krage and I performed maintenance work for this corner on March 9, 2016. We found the stone/pipe/wire as described on William Jung's tie sheet dated 2/14/1986. The stone is up 0.9 feet. The pipe is up 2.8 feet. We found all four of Jung's ties (we found the trees – not the nails). The stone is in a safe place and holding securely so we chose not to set any new ties. We acquired GPS coordinates on the corner. We set a new sign/post 2'± north of the stone facing south.



Bryan H. Meyer – La Crosse County Surveyor

April 18, 2016




21606190020

U. S. PUBLIC LAND SURVEY MONUMENT RECORD

SECTION 19 T 16 N, R 6 W, TOWN OF BARRE

LA CROSSE COUNTY

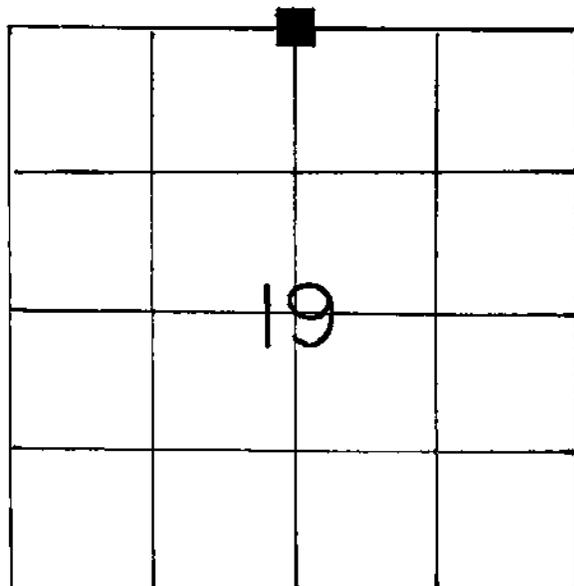

LOCATION OF LANDMARK

Crew: William Jung
 Perry Dahl
 9/18/84

WISCONSIN COORDINATE SYSTEM
North
East
Theta Angle
Horiz. Order
Vert. Order
TYPE OF LANDMARK
STONE MON.
BEARINGS ARE REFERENCED TO

Describe any record evidence, monument evidence, testimonial evidence or any other material evidence you considered and whether the monument was found or restored through acceptance of an obliterated evidence location.


I found a stone at the corner which I accepted as the best available evidence of the original government corner position. This stone has been used as the corner in previous surveys. The center of a rotted stump is $N83^{\circ}W$, 7.2' from the stone. This checks with Middlebrook's 1878 field notes.

Describe or show any material discrepancy between the location of the restored corner and that of the corner previously restored or reestablished.

None known.

RECORD OF DURABLE WITNESS MONUMENTS
MAGNETIC

NO	DESCRIPTION	BEARING	DISTANCE
1	NAIL IN 5 IN. BITTERNUT HICKORY TREE, SINGLE-BLAZED	N57°W	13.29'
2	NAIL IN 5 IN. BITTERNUT HICKORY TREE, SINGLE-BLAZED	N82°W	23.75'
3	NAIL IN 9 IN. BITTERNUT HICKORY TREE, DOUBLE-BLAZED	S54°W	5.17'
4	DUG PIT IN GROUND	S86°E	4.4'±

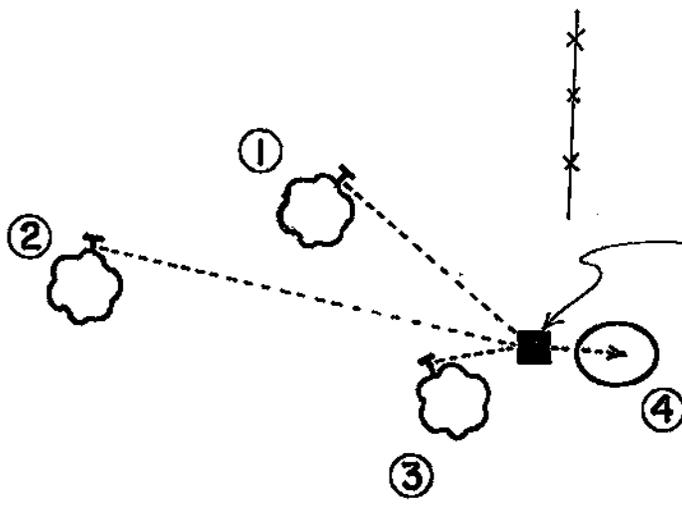

Found a stone in two pieces, 3"x5", with a cross. The third stone piece is buried. I dug a pit and mounded the stone. On the North side of the stone is a 1 3/4" pipe, up 2'. Barb wire is wrapped around the stones and the pipe.

PLAN VIEW DRAWING OF REFERENCE TIES


MAP SHOWING DISTANCE AND DIRECTION TO OTHER PUBLIC LAND SURVEY CORNERS USED FOR REESTABLISHING THE CORNER

No measurements made by me at this time.

I, William C. Jung, Deputy County Surveyor,
HEREBY CERTIFY THAT THE CORNER LOCATION SHOWN ON THIS RECORD
WAS DETERMINED BY ME OR UNDER MY DIRECTION AND CONTROL AND
THAT THIS U. S. PUBLIC LAND SURVEY MONUMENT RECORD IS CORRECT
AND COMPLETE TO THE BEST OF MY KNOWLEDGE AND BELIEF.

William C. Jung
Signature

2/14/86
Date

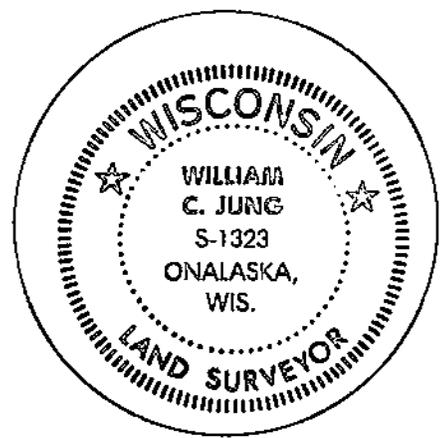

Seal