


21606200020

## U. S. PUBLIC LAND SURVEY MONUMENT RECORD

SECTION 20 T 16 N, R 6 W, TOWN OF BARRE

LA CROSSE COUNTY

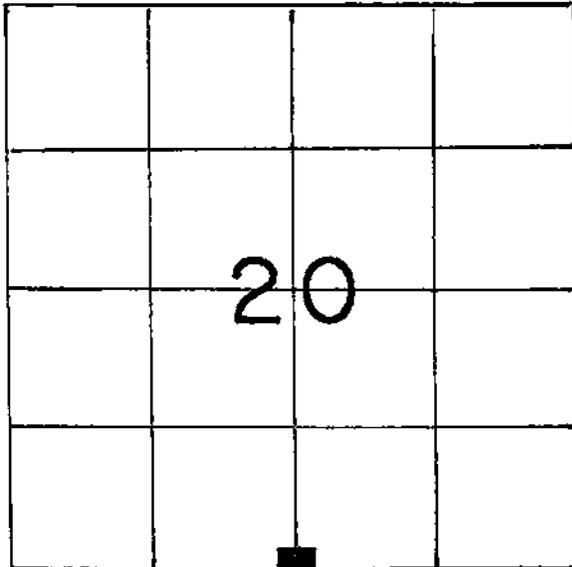

LOCATION OF LANDMARK

Crew: William Jung  
Perry Dahl  
9/17/84

Crew: William C. Jung  
Peter F. Follansbee  
11/15/91 and 7/3/07

## WISCONSIN COORDINATE SYSTEM

North

East

Theta Angle

Horiz. Order

Vert. Order

## TYPE OF LANDMARK

STONE MONUMENT

## BEARINGS ARE REFERENCED TO

Assumed

Describe any record evidence, monument evidence, testimonial evidence or any other material evidence you considered and whether the monument was found or restored through acceptance of an obliterated evidence location.

I found a stone at the corner which I accepted as the best available evidence of the original government corner position. This stone has been used as the corner in previous surveys.

The stone was found off plumb and so was plumbed up. A wine bottle with two shell casings was buried on the North side of the stone, between the stone and post.

7/3/07 - Someone from the Town road crew broke the stone in half. We set the top piece on top of the buried piece of stone and plumbed it back up. A fence post and pipe were driven by the stone to stabilize it. Set another sign and post. Describe or show any material discrepancy between the location of the restored corner and that of the corner previously restored or reestablished.

None known.

