


U. S. PUBLIC LAND SURVEY MONUMENT RECORD

SECTION 21 T 16 N, R 6 W, TOWN OF BARRE  
 LA CROSSE COUNTY

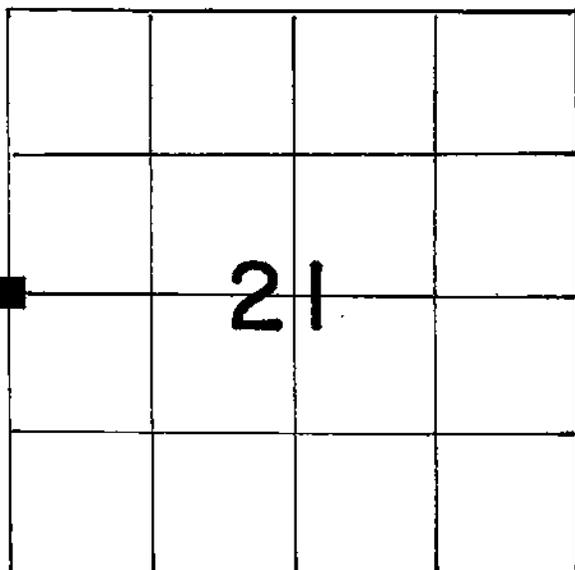

LOCATION OF LANDMARK

WISCONSIN COORDINATE SYSTEM
North
East
Theta Angle
Horiz. Order
Vert. Order
TYPE OF LANDMARK STONE MONUMENT
BEARINGS ARE REFERENCED TO (None shown)

Crew: William Jung  
 Perry Dahl

8/26/85

Describe any record evidence, monument evidence, testimonial evidence or any other material evidence you considered and whether the monument was found or restored through acceptance of an obliterated evidence location.


I found a stone at the corner that had been found and used by Greg Hofmeister in a previous survey.

Describe or show any material discrepancy between the location of the restored corner and that of the corner previously restored or reestablished.

None known.

RECORD OF DURABLE WITNESS MONUMENTS

NO	DESCRIPTION	BEARING	DISTANCE
1	RAILROAD TIE AT FENCE CORNER	WEST+	1319'+
2	P.K. NAIL IN 12" DOUBLE-BLAZED ELM TREE	SOUTH+	1.95'
3	SPIKE NAIL BETWEEN TIE POSTS	EAST±	2.02'
4			

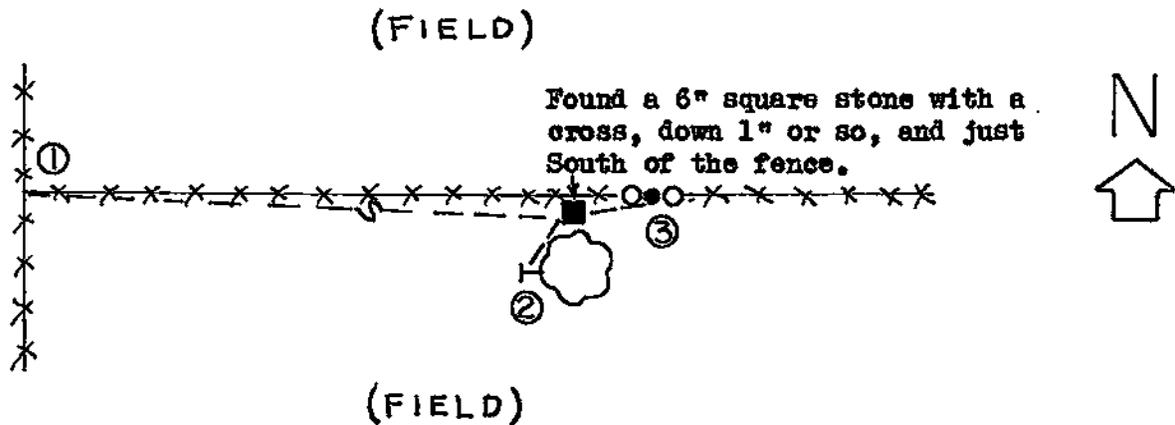

PLAN VIEW DRAWING OF REFERENCE TIES

MAP SHOWING DISTANCE AND DIRECTION TO OTHER PUBLIC LAND SURVEY CORNERS USED FOR REESTABLISHING THE CORNER

None measured by me at this time. Hofmeister had a distance of 2634.88 feet to the NW Corner of Section 21.

I, William G. Jung, Deputy County Surveyor,  
 HEREBY CERTIFY THAT THE CORNER LOCATION SHOWN ON THIS RECORD  
 WAS DETERMINED BY ME OR UNDER MY DIRECTION AND CONTROL AND  
 THAT THIS U. S. PUBLIC LAND SURVEY MONUMENT RECORD IS CORRECT  
 AND COMPLETE TO THE BEST OF MY KNOWLEDGE AND BELIEF.

William C. Jung 10/4/85  
 Signature Date



Seal