


## U. S. PUBLIC LAND SURVEY MONUMENT RECORD

SECTION 21 T 16 N, R 6 W, TOWN OF BARRE  
LA CROSSE COUNTY

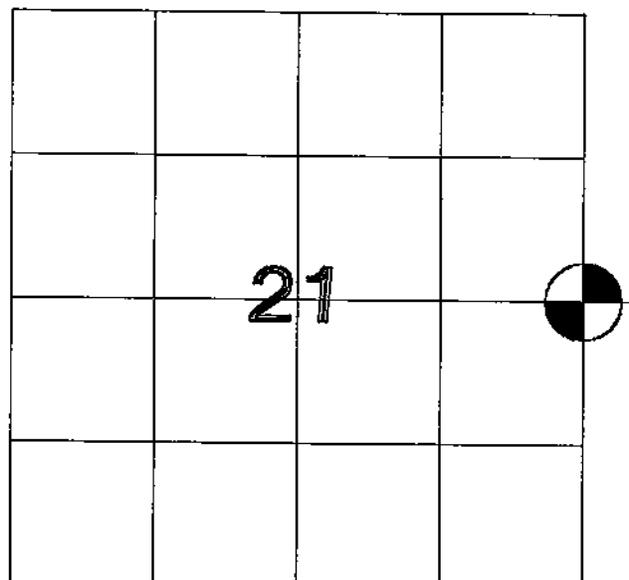

LOCATION OF LANDMARK

CREW: SD

JF

DATE: 9/3/98

Describe any record evidence, monument evidence, testimonial evidence, or any other material evidence you considered and whether the monument was found or restored through acceptance of an obliterated evidence location.

We found an iron pipe near the northeast corner of the SE 1/4 - NE 1/4 and projected a line through said pipe creating an equal distance split between the NE and SE corners. This area had been bulldozed and no evidence remains of the original corner.

Describe or show any material discrepancy between the location of the restored corner and that of the corner previously restored or reestablished.

A previous survey shows the corner as being set, however, the corner appears to have been obliterated by bulldozer activity.

## WISCONSIN COORDINATE SYSTEM

North

East

Theta Angle

Horiz. Order

Vert. Order

## TYPE OF LANDMARK


SET 3/4"X30" IRON BAR

BEARINGS ARE REFERENCED TO

NORTH-SOUTH 1/4 LINE (R.A. N 00°04'08" W)


## RECORD OF DURABLE WITNESS MONUMENTS

NO	DESCRIPTION	BEARING	DISTANCE
1	P.K. NAIL IN 24" SILVER MAPLE	N 23°00'13" E	36.97'
2	P.K. NAIL IN 20" SILVER MAPLE	N 60°56'25" E	66.23'
3	P.K. IN 18" & 24" DOUBLE SILVER MAPLE	S 89°34'32" E	110.91'
4	P.K. NAIL IN 12" BURR OAK	S 11°14'17" E	54.93'

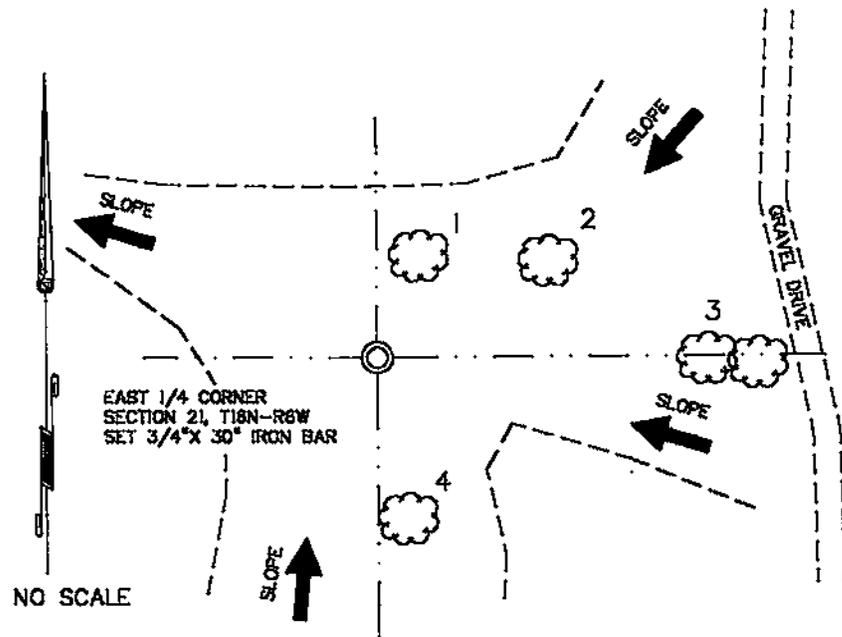


PLAN VIEW DRAWING OF REFERENCE TIES

MAP SHOWING DISTANCE AND DIRECTION TO OTHER PUBLIC LAND SURVEY CORNERS USED FOR REESTABLISHING THE CORNER

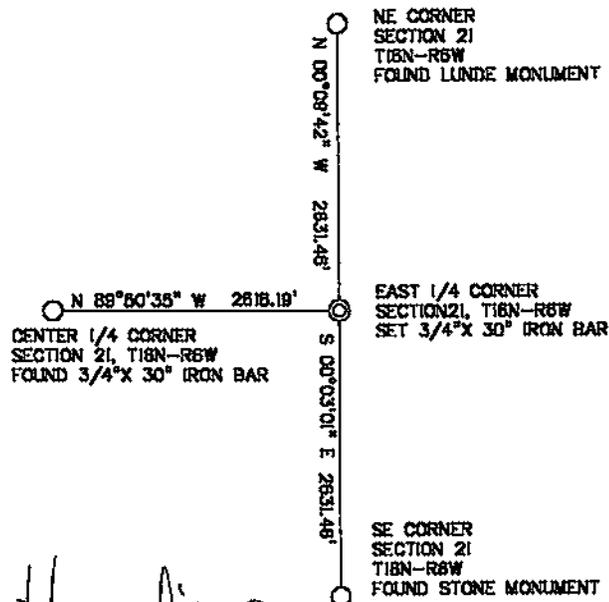

*Michael J. Harding*

HEREBY CERTIFY THAT THE CORNER LOCATION SHOWN ON THIS RECORD WAS DETERMINED BY ME OR UNDER MY DIRECTION AND CONTROL AND THAT THIS U. S. PUBLIC LAND SURVEY MONUMENT RECORD IS CORRECT AND COMPLETE TO THE BEST OF MY KNOWLEDGE AND BELIEF.

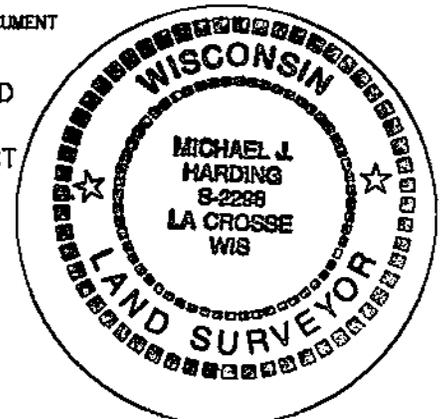

*Michael J. Harding*

Signature

7-14-99

Date

Seal