


21606220000

U. S. PUBLIC LAND SURVEY MONUMENT RECORD

SECTION 22 T 16 N, R 6 W, TOWN OF Barre

LA CROSSE COUNTY

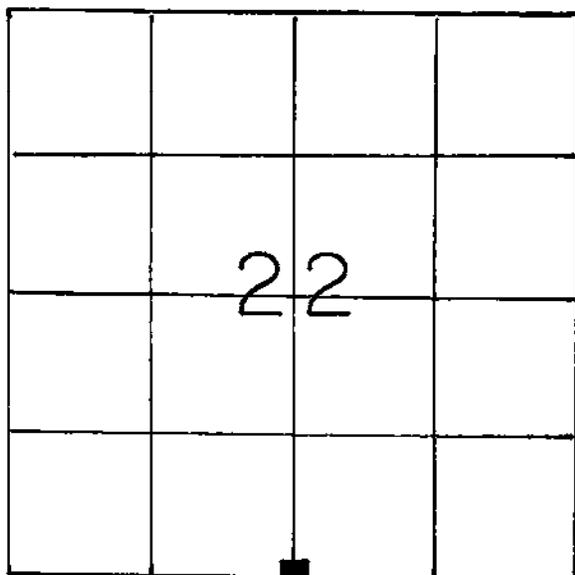

LOCATION OF LANDMARK

Crew: William C. Jung
Peter F. Follansbee

Date: 12/6/88

Describe any record evidence, monument evidence, testimonial evidence or any other material evidence you considered and whether the monument was found or restored through acceptance of an obliterated evidence location.

I found a 6" square stone at the corner and accepted it as the best available evidence of the original government corner position. The stone is Northwest of the fence corner and is buried about 3"

Describe or show any material discrepancy between the location of the restored corner and that of the corner previously restored or reestablished.

None known.

WISCONSIN COORDINATE SYSTEM

North

East

Theta Angle

Horiz. Order

Vert. Order

TYPE OF LANDMARK

Stone


BEARINGS ARE REFERENCED TO

True

RECORD OF DURABLE WITNESS MONUMENTS

NO	DESCRIPTION	BEARING	DISTANCE
1	P.K. nail in a blazed 12" box elder	-----	6.44'
2	" 17" "	-----	8.97'
3	" 17" "	-----	28.03'
4	" 9" "	-----	35.15'


(not to scale)

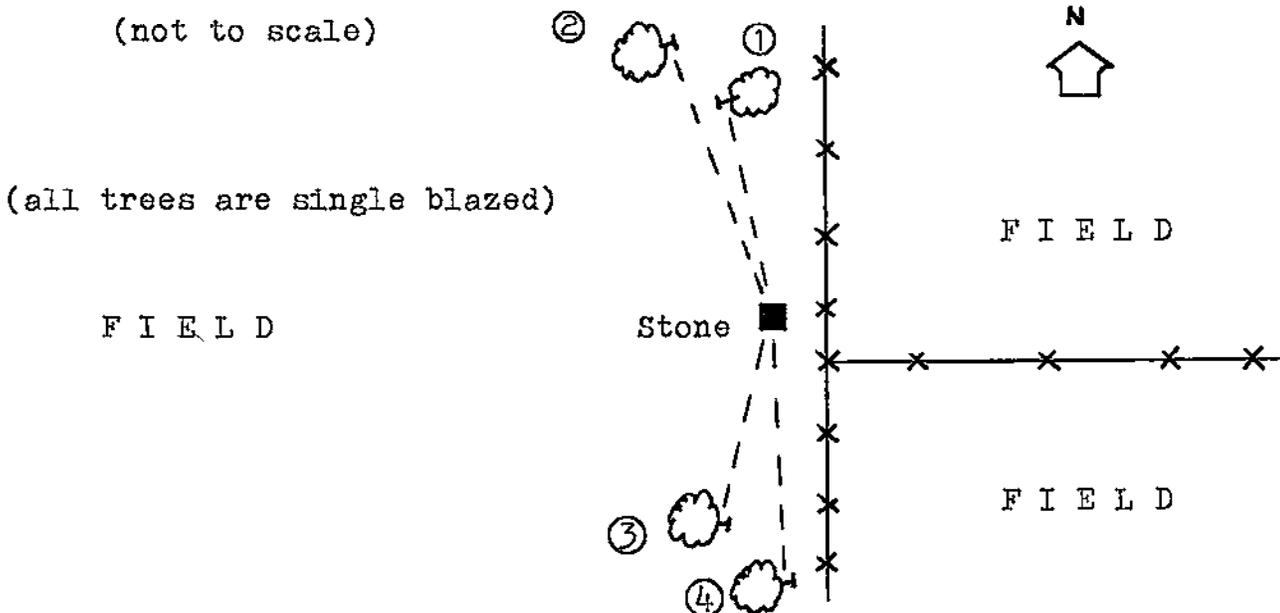

PLAN VIEW DRAWING OF REFERENCE TIES

MAP SHOWING DISTANCE AND DIRECTION TO OTHER PUBLIC LAND SURVEY CORNERS USED FOR REESTABLISHING THE CORNER

(not to scale)

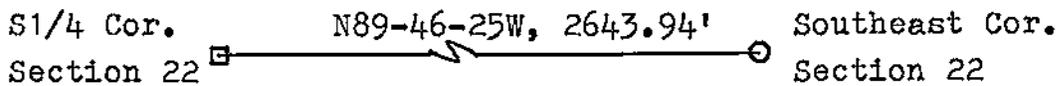

I, William C. Jung, Deputy County Surveyor
 HEREBY CERTIFY THAT THE CORNER LOCATION SHOWN ON THIS RECORD
 WAS DETERMINED BY ME OR UNDER MY DIRECTION AND CONTROL AND
 THAT THIS U. S. PUBLIC LAND SURVEY MONUMENT RECORD IS CORRECT
 AND COMPLETE TO THE BEST OF MY KNOWLEDGE AND BELIEF.

William C. Jung
 Signature

December 30, 1988
 Date



Seal