


21606222000

U. S. PUBLIC LAND SURVEY MONUMENT RECORD

SECTION 23 T 16 N, R 6 W, TOWN OF Barre

LA CROSSE COUNTY

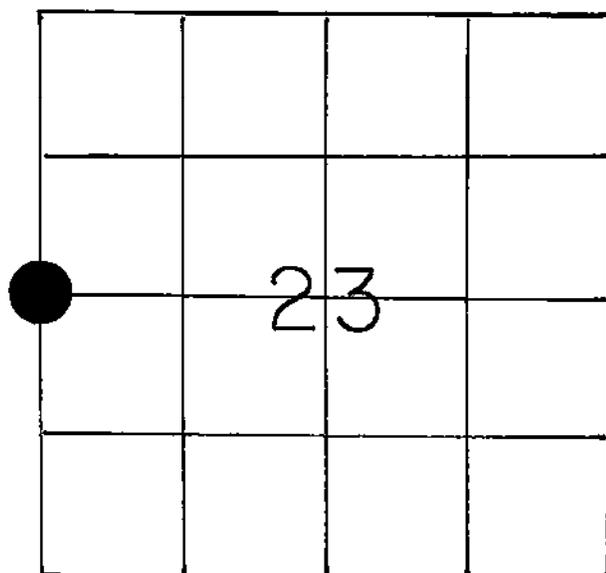

LOCATION OF LANDMARK

Crew: William C. Jung
Peter F. Follansbee

Date: 12/7/88

WISCONSIN COORDINATE SYSTEM
North
East
Theta Angle
Horiz. Order
Vert. Order
TYPE OF LANDMARK
Stone
BEARINGS ARE REFERENCED TO
True

Crew: William C. Jung
Peter F. Follansbee

Date: 4/8/92

Describe any record evidence, monument evidence, testimonial evidence or any other material evidence you considered and whether the monument was found or restored through acceptance of an obliterated evidence location.

I found a 6" square stone at the corner and accepted it as the best available evidence of the original government corner position. The stone is up 6" and scribed "1/4S".

The stone was knocked out by logging equipment. The stone was reset with a post and sign set to the North. A wine bottle with two shell casings was buried by the stone. A square stone was buried to the South of the stone.


Describe or show any material discrepancy between the location of the restored corner and that of the corner previously restored or reestablished.

None known.

RECORD OF DURABLE WITNESS MONUMENTS
Magnetic

NO	DESCRIPTION	BEARING	DISTANCE
1	P.K. in double blazed 12" Scotch pine	N84°W N77°W	42.53' 42.31
2	" 6" hickory	N37°E	35.35' (gone)
3	" 10" Scotch pine	N76°E N79°E	21.05'
4	" 6" hickory	S15°W S20°W	21.20'


SCALE: 1" = 20'

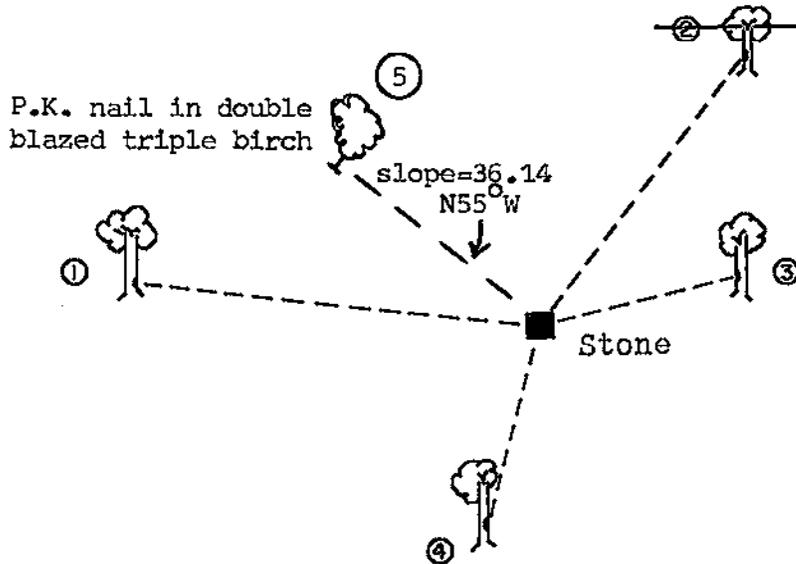

PLAN VIEW DRAWING OF REFERENCE TIES

MAP SHOWING DISTANCE AND DIRECTION TO OTHER PUBLIC LAND SURVEY CORNERS USED FOR REESTABLISHING THE CORNER

(not to scale)

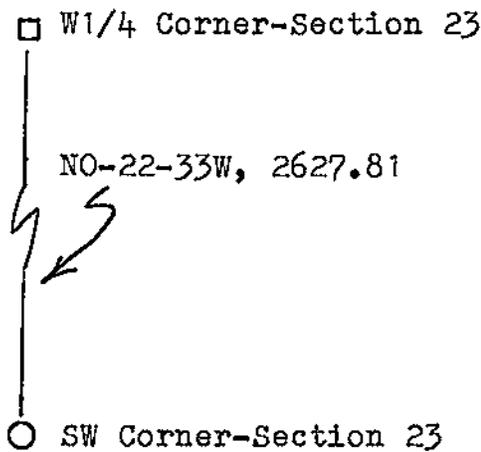


I, William C. Jung, Deputy County Surveyor
HEREBY CERTIFY THAT THE CORNER LOCATION SHOWN ON THIS RECORD WAS DETERMINED BY ME OR UNDER MY DIRECTION AND CONTROL AND THAT THIS U. S. PUBLIC LAND SURVEY MONUMENT RECORD IS CORRECT AND COMPLETE TO THE BEST OF MY KNOWLEDGE AND BELIEF.

William C. Jung
Signature

December 30, 1988
Date

Revised: June 12, 1992

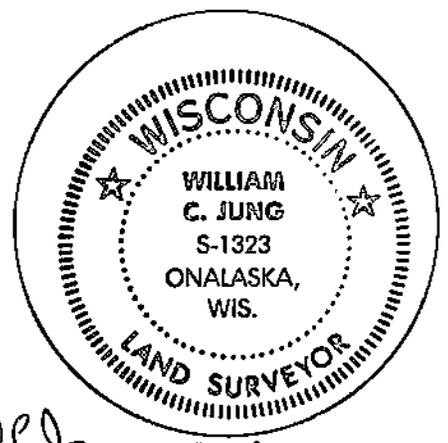

Seal