


U. S. PUBLIC LAND SURVEY MONUMENT RECORD

SECTION 25 T 16 N, R 6 W, TOWN OF BARRE
 LA CROSSE COUNTY

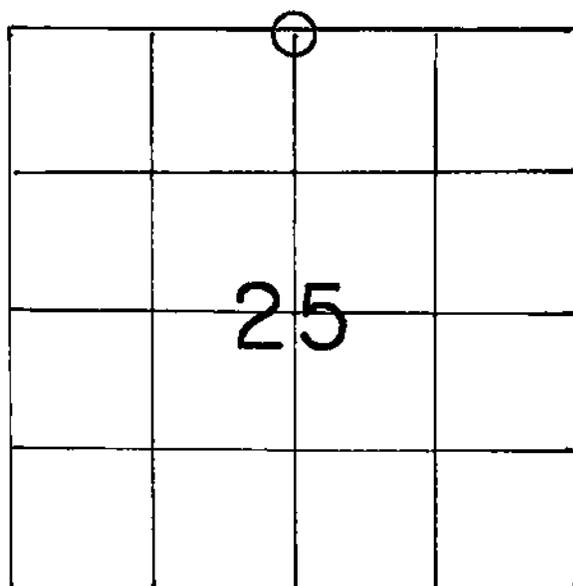

LOCATION OF LANDMARK

WISCONSIN COORDINATE SYSTEM
North
East
Theta Angle
Horiz. Order
Vert. Order
TYPE OF LANDMARK
Set 1 5/8" x 36" Iron Pipe.
BEARINGS ARE REFERENCED TO

Crew: WILLIAM C. JUNG
 PETER F. FOLLANSBEE

Date: 10/13/1994

Describe any record evidence, monument evidence, testimonial evidence or any other material evidence you considered and whether the monument was found or restored through acceptance of an obliterated evidence location.

I found a stone at the corner. The stone was broken into pieces. I accepted the stone as the best available evidence of the original government corner position. I set a pipe at the corner and packed the stone parts around it.

Describe or show any material discrepancy between the location of the restored corner and that of the corner previously restored or reestablished.

None Known.

