


U. S. PUBLIC LAND SURVEY MONUMENT RECORD

SECTION 24 T 16 N, R 6 W, TOWN OF Barre
 LA CROSSE COUNTY

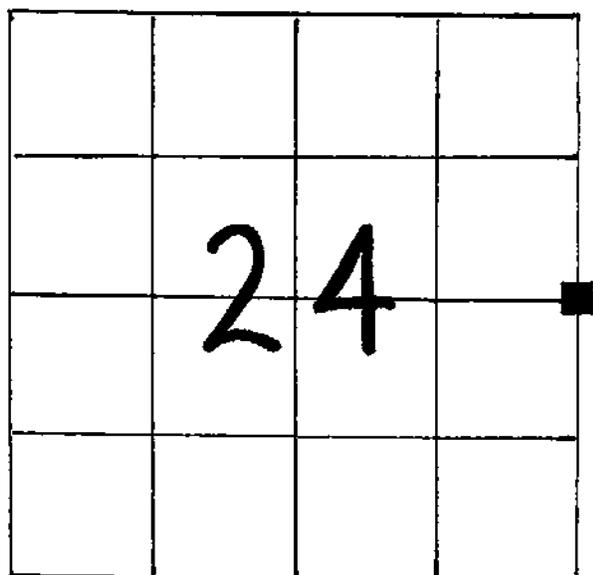

LOCATION OF LANDMARK

WISCONSIN COORDINATE SYSTEM
North
East
Theta Angle
Horiz. Order
Vert. Order
TYPE OF LANDMARK
Stone
BEARINGS ARE REFERENCED TO

Crew: William C. Jung

Jung and Follansbee

Date: 4/19/91

5/13/91

Describe any record evidence, monument evidence, testimonial evidence or any other material evidence you considered and whether the monument was found or restored through acceptance of an obliterated evidence location.

I found a standard 6" square stone scribed with "1/4 S". I accepted the stone as the best available evidence of the original government corner position.

The corner is up 8" or so and leans slightly to the Northwest. I could not plumb it up because of the hickory to the Southeast. The true corner would be about 9" to the Southeast of the stone's center. Ties are to the stone. I buried a brandy bottle with a shell casing on the Northwest side of the stone.

Describe or show any material discrepancy between the location of the restored corner and that of the corner previously restored or reestablished.

None known.

