


21606250020

U. S. PUBLIC LAND SURVEY MONUMENT RECORD

SECTION 36 T 16 N, R 6 W, TOWN OF BARRE

LA CROSSE COUNTY

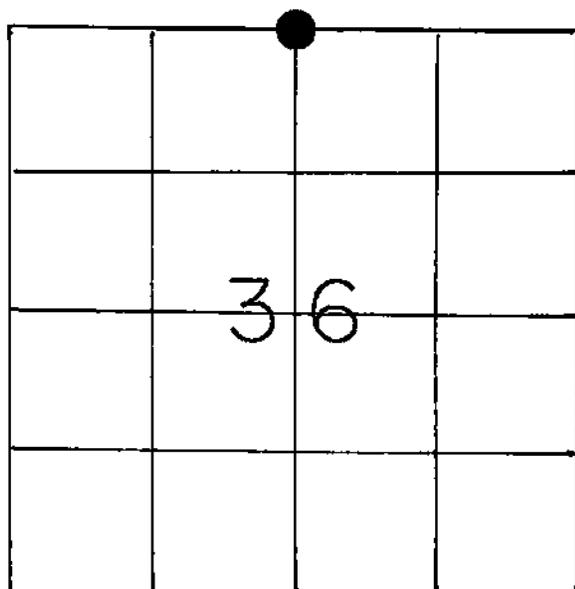

LOCATION OF LANDMARK

WISCONSIN COORDINATE SYSTEM
North
East
Theta Angle
Horiz. Order
Vert. Order
TYPE OF LANDMARK
Brass capped Lunde marker
BEARINGS ARE REFERENCED TO
Assumed

Crew: William C. Jung

Peter F. Follansbee

Date: May 20, 1992

Describe any record evidence, monument evidence, testimonial evidence or any other material evidence you considered and whether the monument was found or restored through acceptance of an obliterated evidence location.

I set an iron pipe at this corner in 1984 and considered it a temporary corner. I have since decided to use it as the 1/4 corner. The pipe was removed and replaced with a brass capped Lunde marker. I accepted the fence to the North as the best evidence of the old 1/4 line. I could not accept the fence to the South.

Describe or show any material discrepancy between the location of the restored corner and that of the corner previously restored or reestablished.

I do not believe that this is the same location as that used by Wil Clark in August of 1977.

