


U. S. PUBLIC LAND SURVEY MONUMENT RECORD

SECTION 35 T 16 N, R 6 W, TOWN OF BARRE

LA CROSSE COUNTY

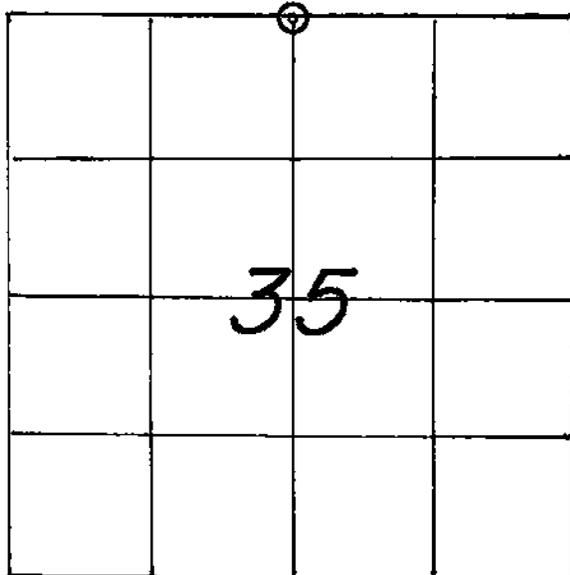

LOCATION OF LANDMARK

WISCONSIN COORDINATE SYSTEM
North
East
Theta Angle
Horiz. Order
Vert. Order

TYPE OF LANDMARK  
P.K. NAIL and cap over ex. P.K. nail

BEARINGS ARE REFERENCED TO  
TRUE NORTH

Crew: WILLIAM C. JUNG  
PETER F. FOLLANSBEE  
Date: 4/26/1996

Crew: William C. Jung  
Peter F. Follansbee  
Date: 9/24/07 \*\*\*\*\*

Describe any record evidence, monument evidence, testimonial evidence or any other material evidence you considered and whether the monument was found or restored through acceptance of an obliterated evidence location.

I set the corner on line and equidistant between the section corners. This best fits the evidence along the North line of the section.

\*\*\*\*\* 9/24/07

The road had just been repaved. The old P.K. nail was below the new layer of pavement. We set a new P.K. nail and cap over the old P.K. nail.  
Describe or show any material discrepancy between the location of the restored corner and that of the corner previously restored or reestablished.

NONE KNOWN.

