


21606262000

## U. S. PUBLIC LAND SURVEY MONUMENT RECORD

SECTION 26 T 16 N, R 6 W, TOWN OF BARRE  
 LA CROSSE COUNTY

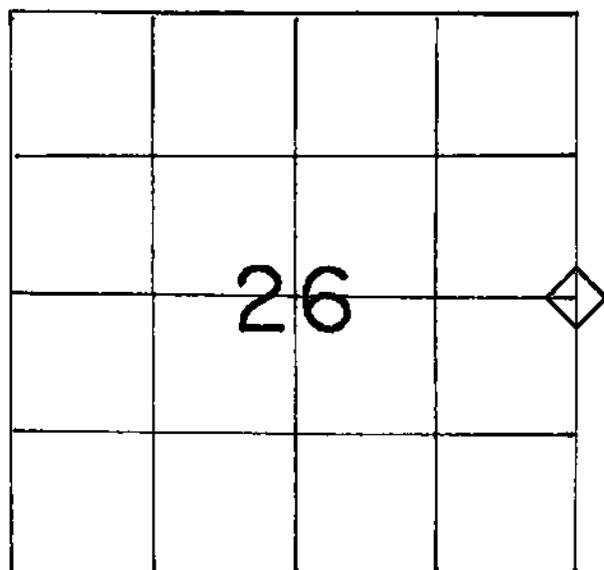

LOCATION OF LANDMARK

Crew: WILLIAM C. JUNG  
 PETER F. FOLLANSBEE  
 Date: 11/16/1994

Describe any record evidence, monument evidence, testimonial evidence or any other material evidence you considered and whether the monument was found or restored through acceptance of an obliterated evidence location.

I found a stone at the corner and accepted it as the best available evidence of the original government corner position. I plumbed the stone back up to the NW.

Describe or show any material discrepancy between the location of the restored corner and that of the corner previously restored or reestablished.

None Known.

## WISCONSIN COORDINATE SYSTEM

North

East

Theta Angle

Horiz. Order

Vert. Order


## TYPE OF LANDMARK

Existing 6" square Stone.

BEARINGS ARE REFERENCED TO

RECORD OF DURABLE WITNESS MONUMENTS  
MAGNETIC

NO	DESCRIPTION	BEARING	DISTANCE
1	Set P.K. Nail in NW-side 10" Oak	S 15° W	16.27 Ft.
2	Set P.K. Nail in SE-side 10" Oak	S 55° W	4.10 Ft.
3	Set P.K. Nail in NE-side 8" Oak	N 20° W	7.49 Ft.
4	Set P.K. Nail in SE-side 8" Oak	N 10° E	9.24 Ft.

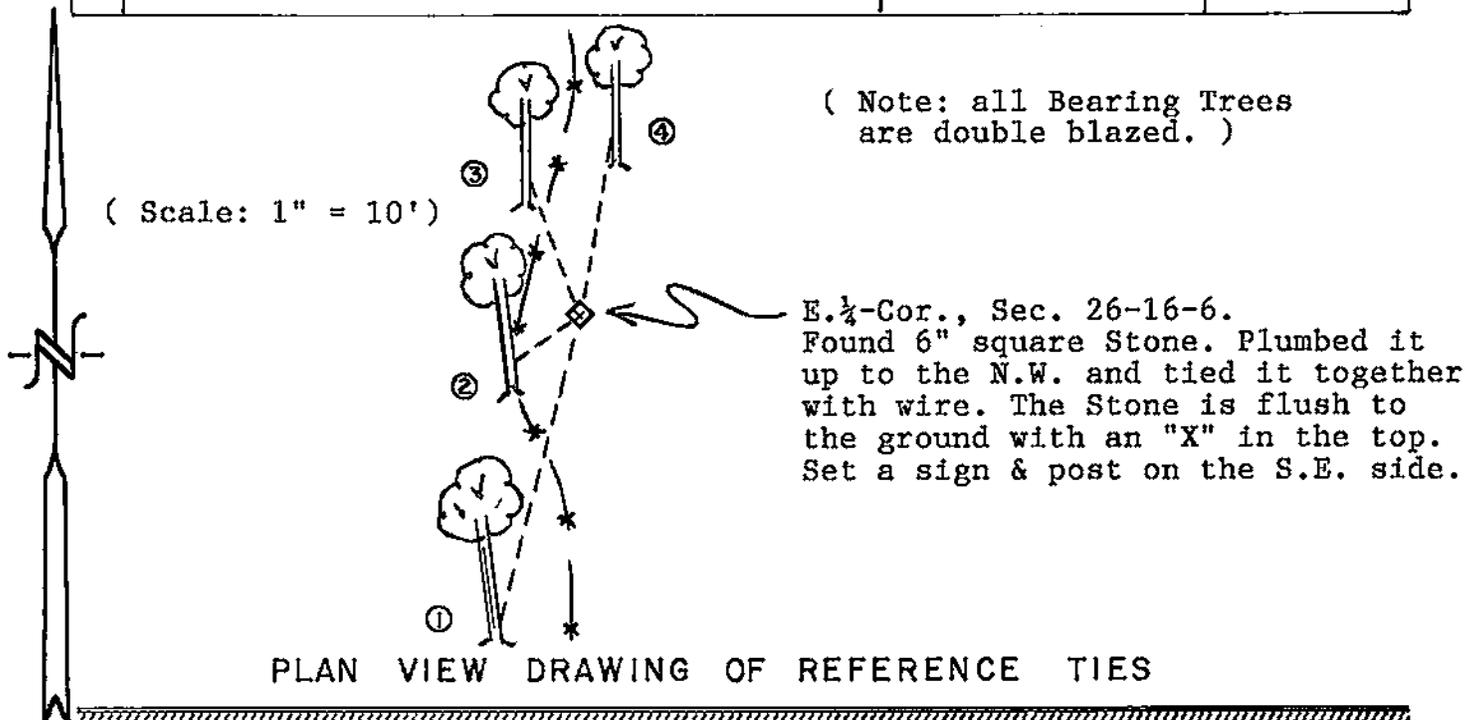


MAP SHOWING DISTANCE AND DIRECTION TO OTHER PUBLIC LAND SURVEY CORNERS USED FOR REESTABLISHING THE CORNER

No section measurements were taken by me at this time. K. Don Pederson confirmed this position by actual field traverse.

I, William C. Jung, County Surveyor  
HEREBY CERTIFY THAT THE CORNER LOCATION SHOWN ON THIS RECORD WAS DETERMINED BY ME OR UNDER MY DIRECTION AND CONTROL AND THAT THIS U. S. PUBLIC LAND SURVEY MONUMENT RECORD IS CORRECT AND COMPLETE TO THE BEST OF MY KNOWLEDGE AND BELIEF.

William C. Jung  
Signature

2/24/95  
Date

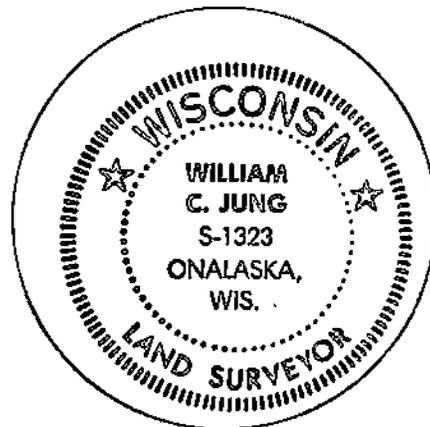

Seal