


U. S. PUBLIC LAND SURVEY MONUMENT RECORD

SECTION 34 T 16 N, R 6 W, TOWN OF BARRE
 LA CROSSE COUNTY

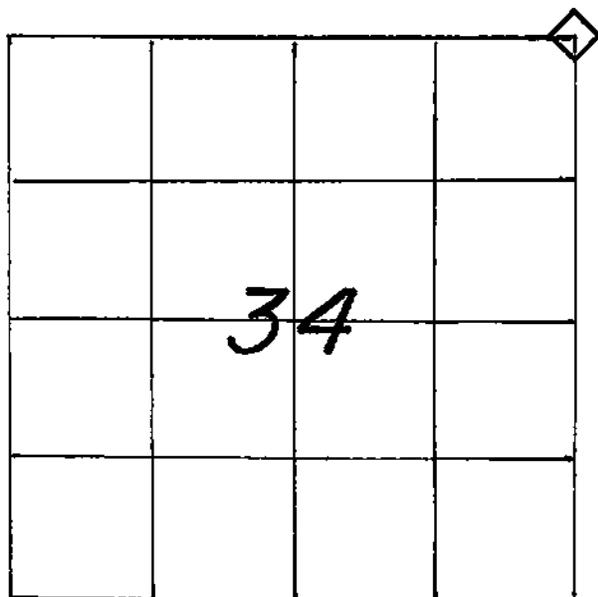

LOCATION OF LANDMARK

| |
|-----------------------------|
| WISCONSIN COORDINATE SYSTEM |
| North |
| East |
| Theta Angle |
| Horiz. Order |
| Vert. Order |
| TYPE OF LANDMARK |
| Existing 6" square Stone. |
| BEARINGS ARE REFERENCED TO |
| True North |

Crew: WILLIAM C. JUNG
 PETER F. FOLLANSBEE
 Date: 4/22/1996

Describe any record evidence, monument evidence, testimonial evidence or any other material evidence you considered and whether the monument was found or restored through acceptance of an obliterated evidence location.


I found a stone at the corner and accepted it as the best available evidence of the original government corner position.

Describe or show any material discrepancy between the location of the restored corner and that of the corner previously restored or reestablished.


There is an iron pipe 9.43 feet to the North of the stone. I did not accept the pipe as the section corner.

RECORD OF DURABLE WITNESS MONUMENTS

| NO | DESCRIPTION | BEARING | DISTANCE |
|----|-------------------------------------|---------------------|------------|
| 1 | Set 1" Iron Pipe 6"s west of fence | South \pm | 10.64 Ft. |
| 2 | Ex. 2" x 30" Iron Pipe under fence | North \pm | 9.43 Ft. |
| 3 | Set 1" Iron Pipe 17"s east of fence | Northeasterly \pm | 22.05 Ft., |
| 4 | Ex. 1" Iron Pipe east of fence | Southeasterly \pm | 22.39 Ft. |

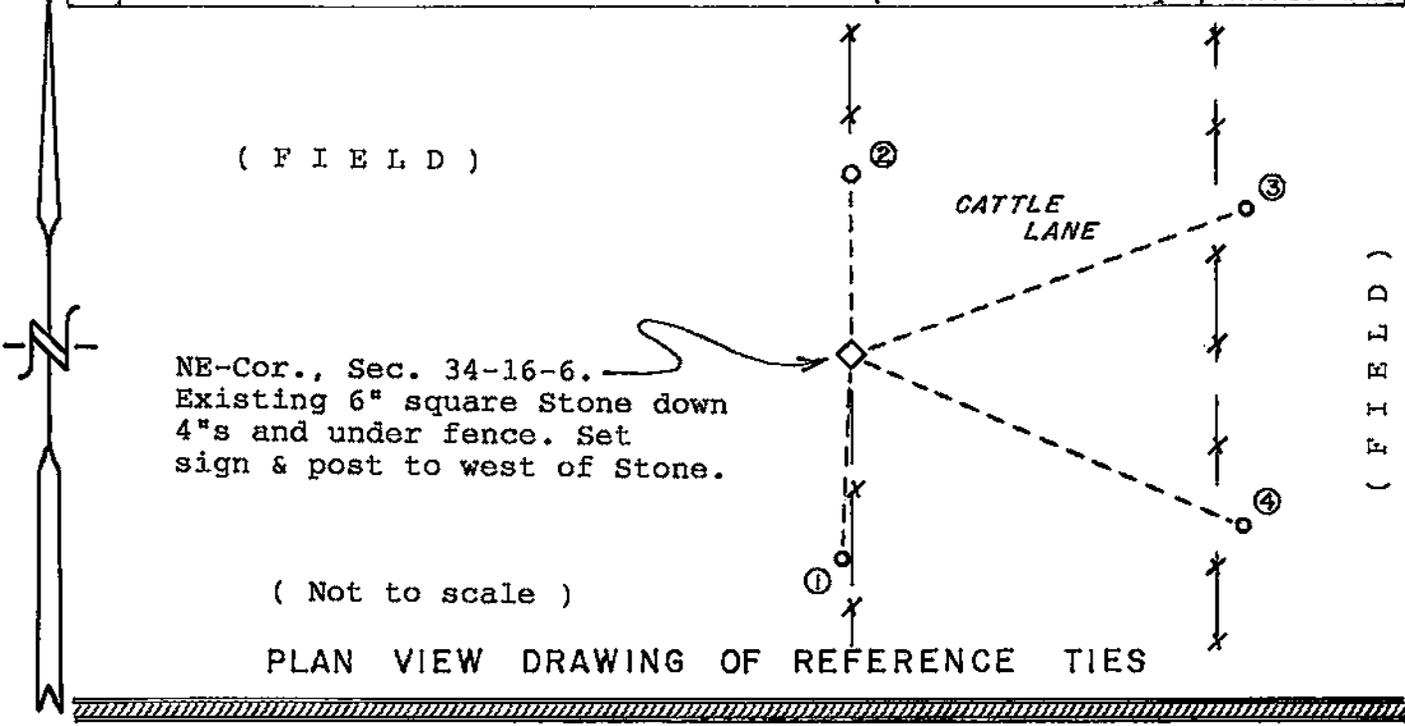

MAP SHOWING DISTANCE AND DIRECTION TO OTHER PUBLIC LAND SURVEY CORNERS USED FOR REESTABLISHING THE CORNER
(not to scale)

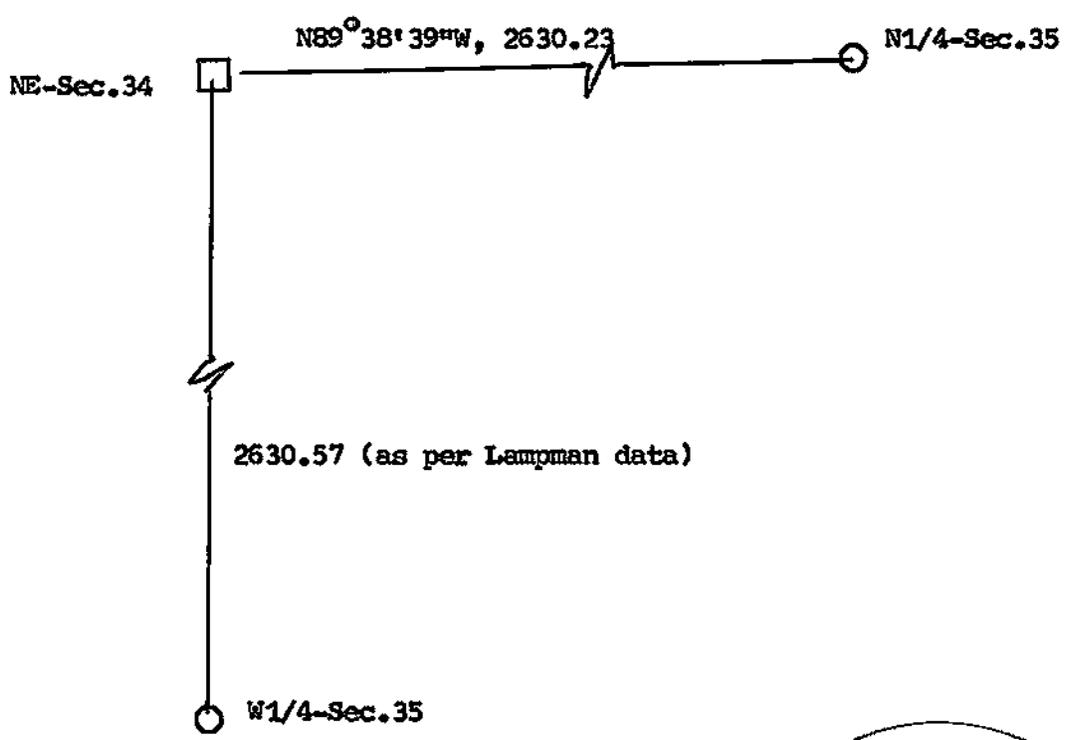

I, William C. Jung, County Surveyor
 HEREBY CERTIFY THAT THE CORNER LOCATION SHOWN ON THIS RECORD
 WAS DETERMINED BY ME OR UNDER MY DIRECTION AND CONTROL AND
 THAT THIS U. S. PUBLIC LAND SURVEY MONUMENT RECORD IS CORRECT
 AND COMPLETE TO THE BEST OF MY KNOWLEDGE AND BELIEF.

William C. Jung 5/28/96
 Signature Date



Seal

U. S. PUBLIC LAND SURVEY MONUMENT RECORD

SECTION 34 T 16 N, R 6 W, TOWN OF BARRE

LA CROSSE COUNTY

| | | | |
|--|--------|-------|--|
| | | | |
| | SEC. | 34 | |
| | T 16 N | R 6 W | |
| | | | |

LOCATION OF LANDMARK

WISCONSIN COORDINATE SYSTEM

North

East

Theta Angle

Horiz. Order

Vert. Order

TYPE OF LANDMARK

2" X 30" IRON PIPE

BEARINGS ARE REFERENCED TO
the West line of Section 34, T 16 N,
R 6 W, Assumed Bearing $N0^{\circ}58'16''W$.

Describe any record evidence, monument evidence, testimonial evidence or any other material evidence you considered and whether the monument was found or restored through acceptance of an obliterated evidence location.


The NE corner of Section 34 was restored through acceptance of occupational evidence together with extensive survey information gathered throughout Section 34 to assist in verifying this corner.

Describe or show any material discrepancy between the location of the restored corner and that of the corner previously restored or reestablished.

N/A


NE CORNER OF SECTION 34, T 16 N, R 6 W, TOWN OF BARRE, LACROSSE CO.
 RECORD OF DURABLE WITNESS MONUMENTS

| NO | DESCRIPTION | BEARING | DISTANCE |
|----|--|---------|----------|
| 1 | SET 1" O.D. X 30" IRON PIPE | N 40° E | 29.08' |
| 2 | SET 1" O.D. X 30" IRON PIPE | S 45° E | 28.18' |
| 3 | 22" DIAM. CHERRY TREE, SET P.K. NAIL AT BASE AND ON EAST SIDE. | NORTH | 19.90' |
| 4 | NO OTHERS NEAR. | | |

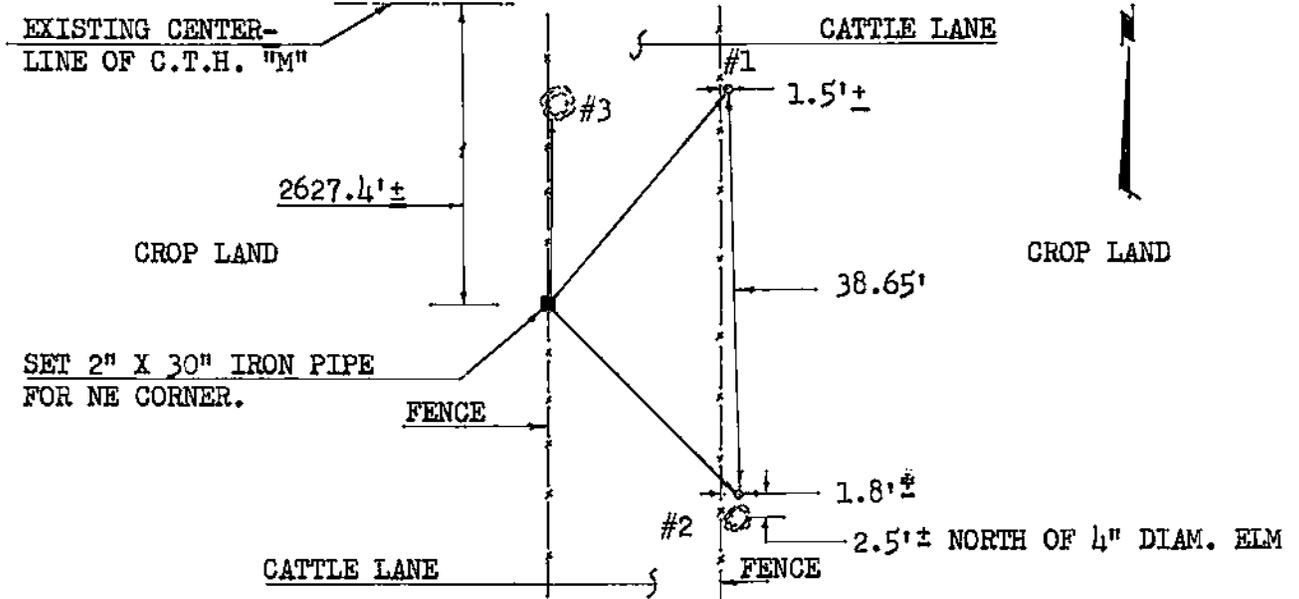


PLAN VIEW DRAWING OF REFERENCE TIES

MAP SHOWING DISTANCE AND DIRECTION TO OTHER PUBLIC LAND SURVEY CORNERS USED FOR REESTABLISHING THE CORNER

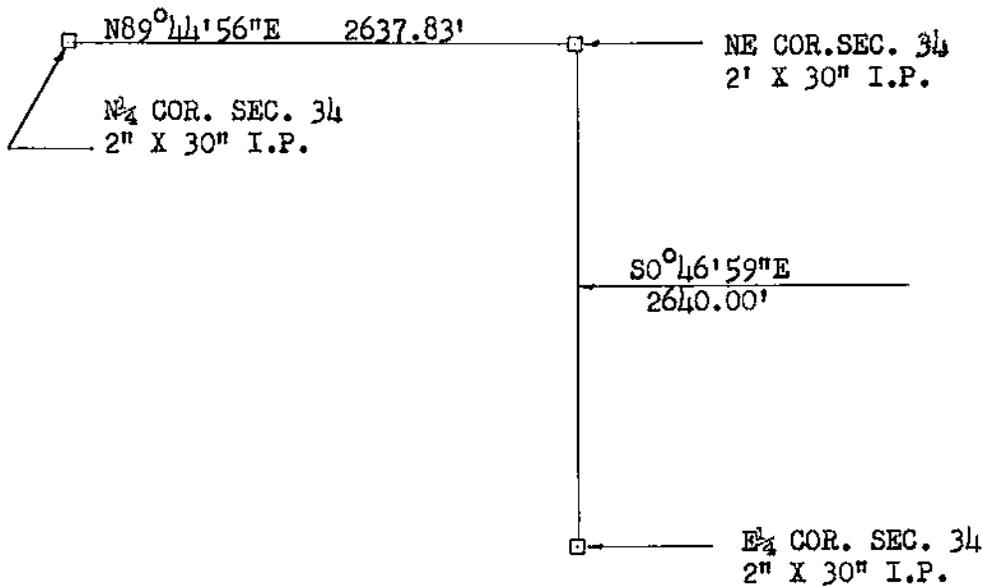

I, Robert M. Lampman, Registered land Surveyor, do
 HEREBY CERTIFY THAT THE CORNER LOCATION SHOWN ON THIS RECORD
 WAS DETERMINED BY ME OR UNDER MY DIRECTION AND CONTROL AND
 THAT THIS U. S. PUBLIC LAND SURVEY MONUMENT RECORD IS CORRECT
 AND COMPLETE TO THE BEST OF MY KNOWLEDGE AND BELIEF.

Robert M. Lampman Signature March 12, 1964 Date

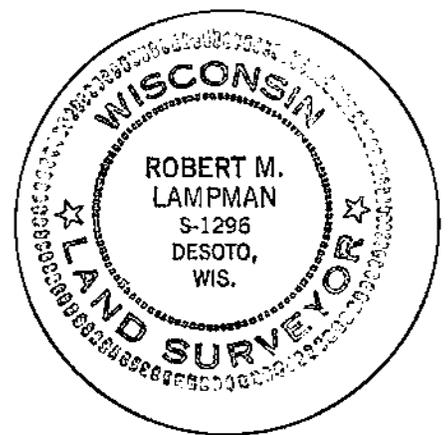

Seal