

21606270020

U. S. PUBLIC LAND SURVEY MONUMENT RECORD

SECTION 34 T 16 N, R 6 W, TOWN OF BARRE

LA CROSSE COUNTY

	SEC.	34	
	T 16 N	R 6 W	

LOCATION OF LANDMARK

WISCONSIN COORDINATE SYSTEM

North

East

Theta Angle

Horiz. Order

Vert. Order

TYPE OF LANDMARK

2" X 30" IRON PIPE

BEARINGS ARE REFERENCED TO

Describe any record evidence, monument evidence, testimonial evidence or any other material evidence you considered and whether the monument was found or restored through acceptance of an obliterated evidence location.


The $N\frac{1}{4}$ corner of Section 34 was restored by acceptance of occupational evidence and was set on line between the NW corner and the NE corner of said Section 34 together with extensive survey information gathered throughout Section 34 to assist in verifying this corner location.

Describe or show any material discrepancy between the location of the restored corner and that of the corner previously restored or reestablished.

N/A


N 1/4 CORNER OF SECTION 34, T 16 N, R 6 W, TOWN OF BARRE, LACROSSE CO.
 RECORD OF DURABLE WITNESS MONUMENTS

NO	DESCRIPTION	BEARING	DISTANCE
1	SET 1" O.D. X 30" IRON PIPE	N25°E	57.12 feet
2	3" DIAM. ELM TREE, SET P.K. NAIL AT BASE AND ON THE NORTH SIDE OF TREE.	S82°E	26.96 feet
3	3" DIAM. CHERRY TREE, SET P.K. NAIL AT BASE AND ON THE NORTH SIDE OF TREE.	S50°E	33.80 feet
4	5" DIAM. ELM TREE, SET P.K. NAIL AT BASE AND ON THE NORTH SIDE OF TREE.	S30°E	56.86 feet

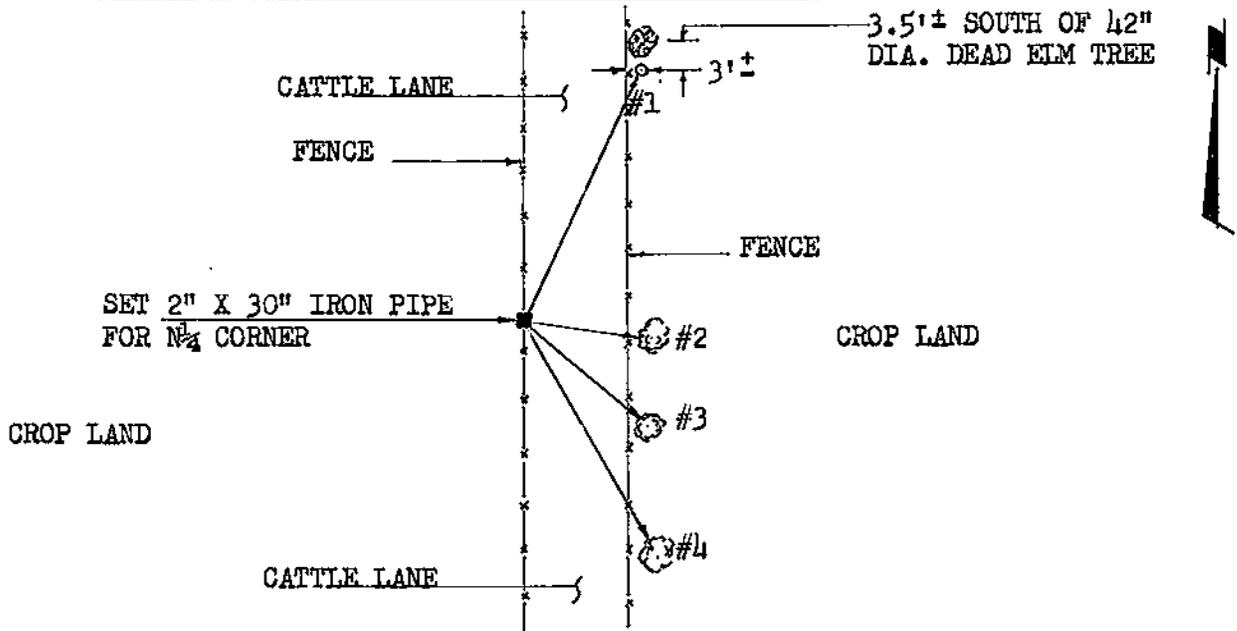


PLAN VIEW DRAWING OF REFERENCE TIES

MAP SHOWING DISTANCE AND DIRECTION TO OTHER PUBLIC LAND SURVEY CORNERS USED FOR REESTABLISHING THE CORNER

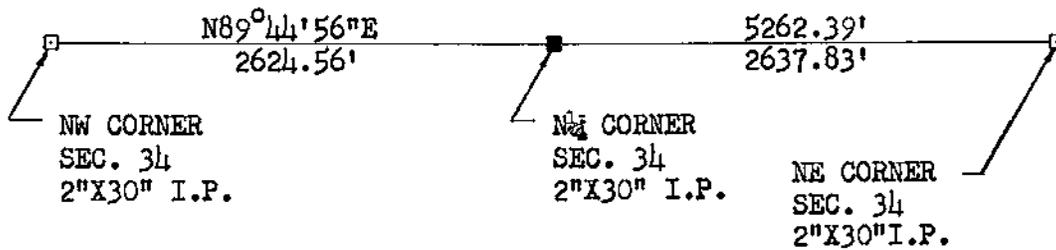

I, Robert M. Lampman, Registered Land Surveyor, do
 HEREBY CERTIFY THAT THE CORNER LOCATION SHOWN ON THIS RECORD
 WAS DETERMINED BY ME OR UNDER MY DIRECTION AND CONTROL AND
 THAT THIS U. S. PUBLIC LAND SURVEY MONUMENT RECORD IS CORRECT
 AND COMPLETE TO THE BEST OF MY KNOWLEDGE AND BELIEF.

Robert M. Lampman March 12, 1964
 Signature Date

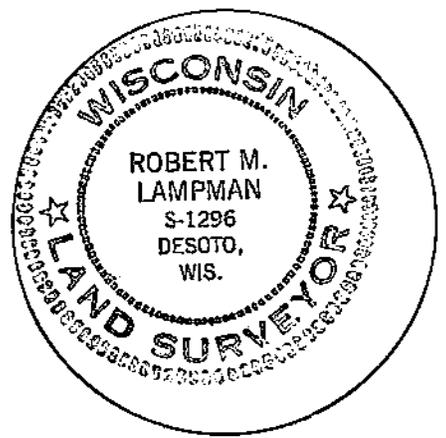

Seal