

21606280000

U. S. PUBLIC LAND SURVEY MONUMENT RECORD

SECTION 34 T 16 N, R 6 W, TOWN OF BARRE

LA CROSSE COUNTY

	SEC.	34	
	T 16 N	R 6 W	

LOCATION OF LANDMARK

WISCONSIN COORDINATE SYSTEM

North

East

Theta Angle

Horiz. Order

Vert. Order

TYPE OF LANDMARK

NE COR. 2" X 30" IRON PIPE

BEARINGS ARE REFERENCED TO
THE WEST LINE OF SEC. 34, T16N,
R6W, ASSUMED BEARING NO 58'16"W.

Describe any record evidence, monument evidence, testimonial evidence or any other material evidence you considered and whether the monument was found or restored through acceptance of an obliterated evidence location.


The NW corner of Section 34 was restored through acceptance of occupational evidence together with extensive survey information gathered throughout Section 34 to assist in verifying this corner location.

Describe or show any material discrepancy between the location of the restored corner and that of the corner previously restored or reestablished.

N/A


NW CORNER OF SECTION 34, T 16 N, R 6 W, TOWN OF BARRE, LACROSSE CO.
 RECORD OF DURABLE WITNESS MONUMENTS

NO	DESCRIPTION	BEARING	DISTANCE
1	32" DIAM. WHITE OAK, SET P.K. NAIL AT BASE AND ON SOUTH SIDE OF TREE.	N 10° E	1.70 FEET
2	8" DIAM. ASH, SET P.K. NAIL AT BASE AND ON NORTHEAST SIDE OF TREE.	S 45° E	51.67 FEET
3	6" DIAM. ASH, SET P.K. NAIL AT BASE AND ON EAST SIDE OF TREE.	S 25° E	46.90 FEET
4	12" DIAM. LOCUST, SET P.K. NAIL 7± ABOVE GROUND AND ON EAST SIDE.	S 12° E	23.88 FEET

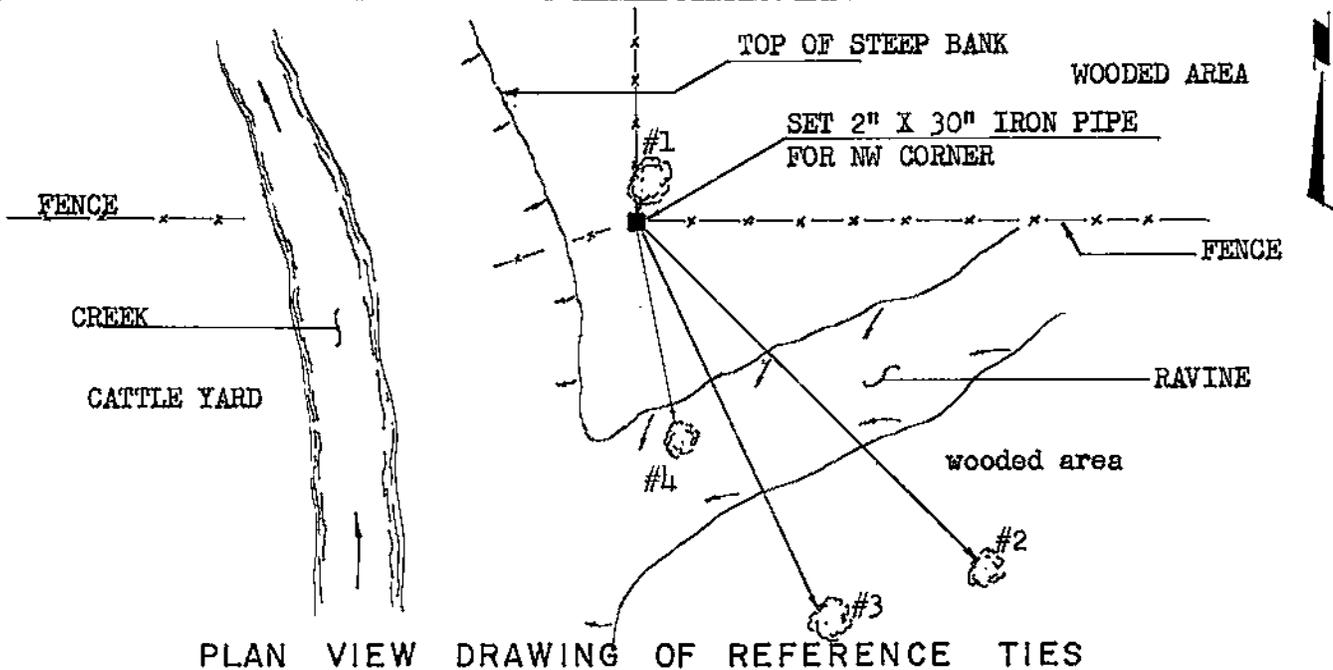

PLAN VIEW DRAWING OF REFERENCE TIES

MAP SHOWING DISTANCE AND DIRECTION TO OTHER PUBLIC LAND SURVEY CORNERS USED FOR REESTABLISHING THE CORNER

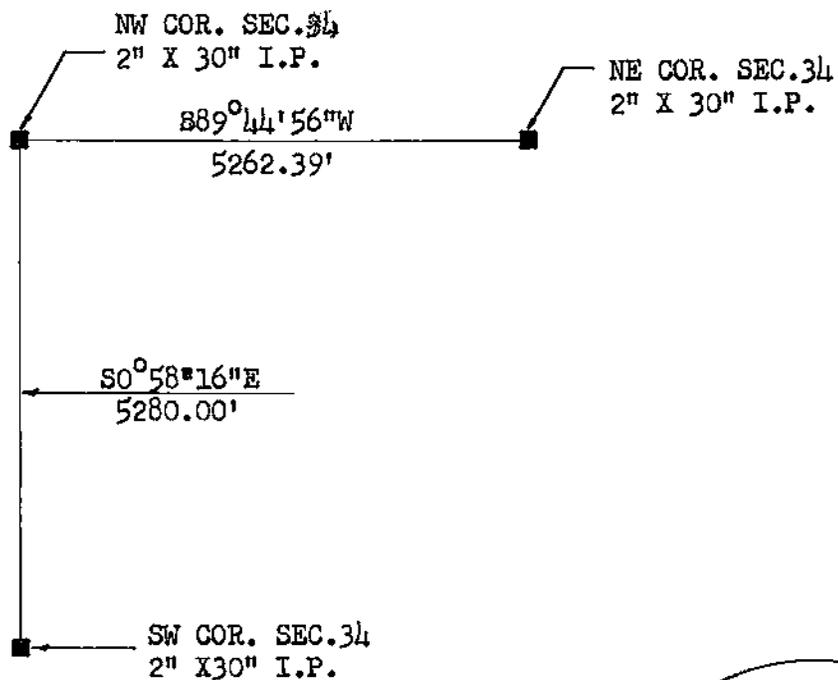

I, Robert M. Lampman, Registered Land Surveyor, do
 HEREBY CERTIFY THAT THE CORNER LOCATION SHOWN ON THIS RECORD
 WAS DETERMINED BY ME OR UNDER MY DIRECTION AND CONTROL AND
 THAT THIS U. S. PUBLIC LAND SURVEY MONUMENT RECORD IS CORRECT
 AND COMPLETE TO THE BEST OF MY KNOWLEDGE AND BELIEF.

Robert M. Lampman
 Signature

March 12, 1984
 Date



Seal