


21606280020

U. S. PUBLIC LAND SURVEY MONUMENT RECORD

SECTION 28 T 16 N, R 6 W, TOWN OF BARRE

LA CROSSE COUNTY

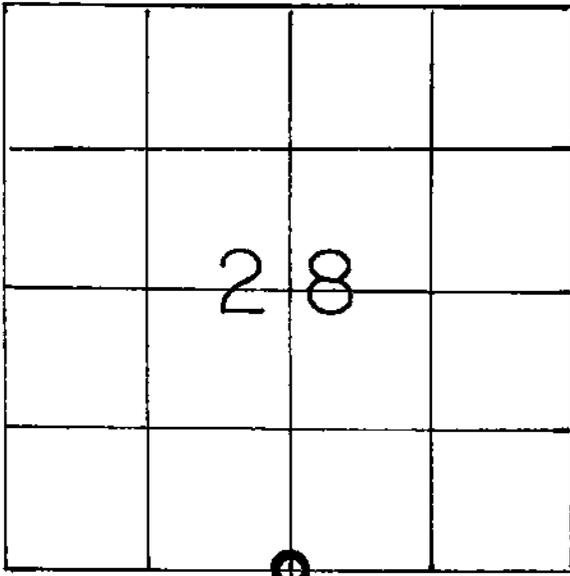

LOCATION OF LANDMARK

CREW: WILLIAM C. JUNG  
 PETER F. FOLLANSBEE  
 DATE: 6/22/1998

WISCONSIN COORDINATE SYSTEM
North
East
Theta Angle
Horiz. Order
Vert. Order
TYPE OF LANDMARK
3/4" x 30" IRON BAR WITH ALUMINUM CAP
BEARINGS ARE REFERENCED TO
Assumed


Describe any record evidence, monument evidence, testimonial evidence or any other material evidence you considered and whether the monument was found or restored through acceptance of an obliterated evidence location.

I set a 3/4"x30" round iron bar with a cap in a 1" iron pipe on the Northwest side of a large white oak. There appeared to be an old scar on the Northwest side of this tree. This point falls at the occupied corner using the North-South fence and good fences to the East and West projected to this point. We searched, dug, and probed at length for the old stone on three different occasions but found nothing. I accepted the occupied corner as the best available evidence of the original government corner. Describe or show any material discrepancy between the location of the restored corner and that of the corner previously restored or reestablished. position.

NONE KNOWN.

RECORD OF DURABLE WITNESS MONUMENTS


NO	DESCRIPTION	BEARING	DISTANCE
1	SET A NAIL IN N.E.-SIDE OF AN 11-1/2" HICKORY	N 40° W(MAG.)	SL. = 65.72'
2	SET A NAIL IN W.-SIDE OF A 22" WHITE OAK	NORTH ±	10.14 FT.
3	DISTANCE TO CENTER OF A 3-1/2" ELM	NORTH ±	2.73 FT.
4	SET A NAIL IN W.-SIDE OF A 9" HICKORY	SOUTH ±	6.97 FT.

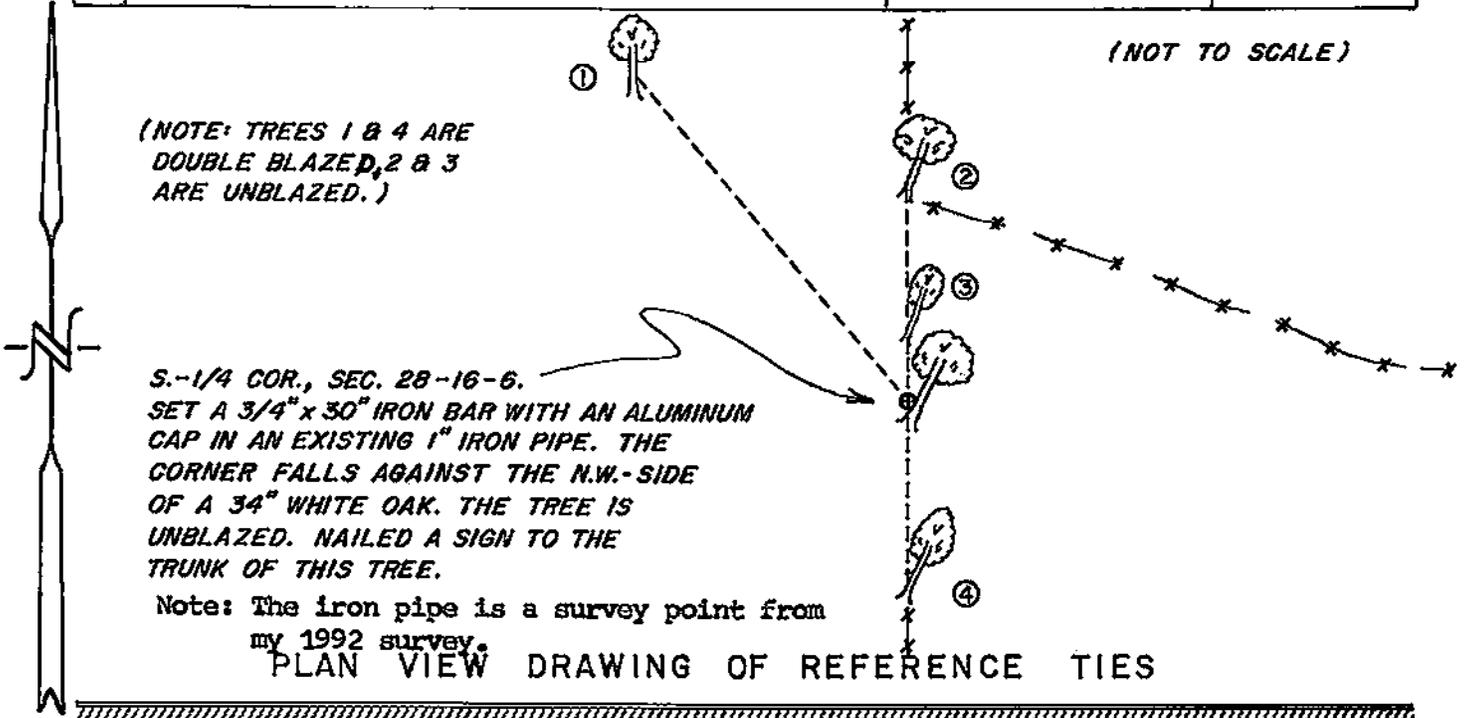

MAP SHOWING DISTANCE AND DIRECTION TO OTHER PUBLIC LAND SURVEY CORNERS USED FOR REESTABLISHING THE CORNER

(M. HARDING MEASUREMENTS)

(not to scale)

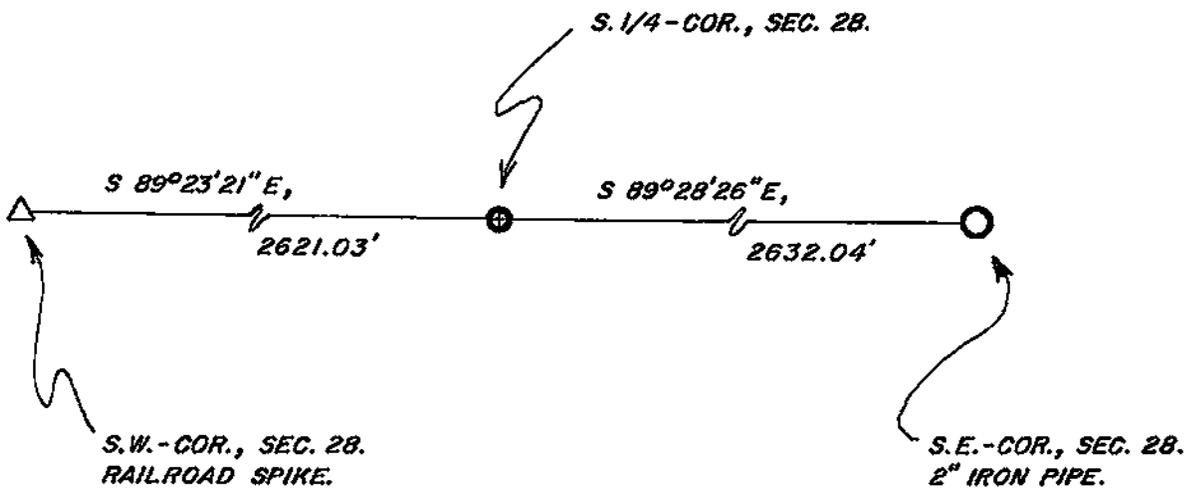

I, WILLIAM C. JUNG, COUNTY SURVEYOR  
 HEREBY CERTIFY THAT THE CORNER LOCATION SHOWN ON THIS RECORD WAS DETERMINED BY ME OR UNDER MY DIRECTION AND CONTROL AND THAT THIS U. S. PUBLIC LAND SURVEY MONUMENT RECORD IS CORRECT AND COMPLETE TO THE BEST OF MY KNOWLEDGE AND BELIEF.

William C. Jung 8/24/98  
 Signature Date

