


21606282000

U. S. PUBLIC LAND SURVEY MONUMENT RECORD

SECTION 28 T 16 N, R 6 W, TOWN OF BARRE

LA CROSSE COUNTY

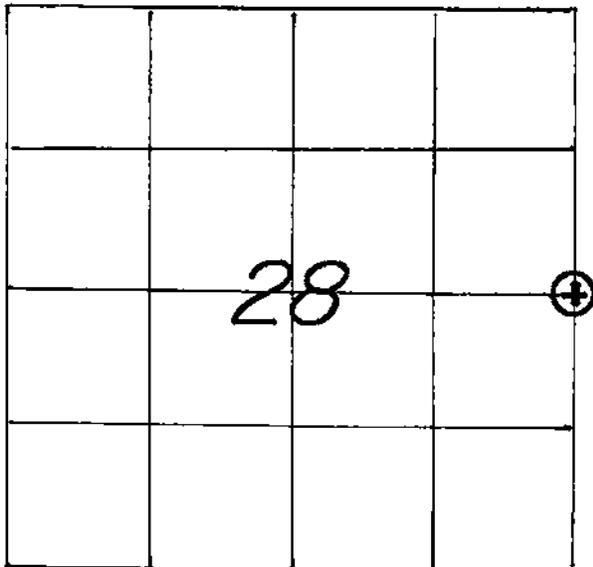

WISCONSIN COORDINATE SYSTEM

North

East

Theta Angle

Horiz. Order

Vert. Order

TYPE OF LANDMARK

3/4" x 30" IRON BAR WITH ALUMINUM CAP.

BEARINGS ARE REFERENCED TO

LOCATION OF LANDMARK

CREW: *WILLIAM C. JUNG*
PETER F. FOLLANSBEE
 DATE: *10/15/2001*


Describe any record evidence, monument evidence, testimonial evidence or any other material evidence you considered and whether the monument was found or restored through acceptance of an obliterated evidence location.

Randy Connell and I discussed this corner at length on 2/10/00. We agreed that it should be set over 2 feet North of the occupied corner. Mike Harding found a nail that he agreed with. Rodney Maxwell apparently used this as the corner while surveying to the East. It would appear that the nail is at the location that Randy and I agreed on. The nail was replaced with an iron bar and cap. We searched at length for a stone, as we had done previously, but found nothing. Describe or show any material discrepancy between the location of the restored corner and that of the corner previously restored or reestablished.

NONE KNOWN.

RECORD OF DURABLE WITNESS MONUMENTS

NO	DESCRIPTION	BEARING	DISTANCE
1	SET A 3/4" x 30" IRON BAR 1' NORTH OF FENCE	WEST ±	36.03 FT.
2	SET A 3/4" x 30" IRON BAR 1' WEST OF FENCE	NORTH ±	30.25 FT.
3	SET A 3/4" x 30" IRON BAR 1' NORTH OF FENCE	S 76° E (MAG.)	30.08 FT.
4	SET A 3/4" x 30" IRON BAR 1' WEST OF FENCE	SOUTH ±	30.06 FT.

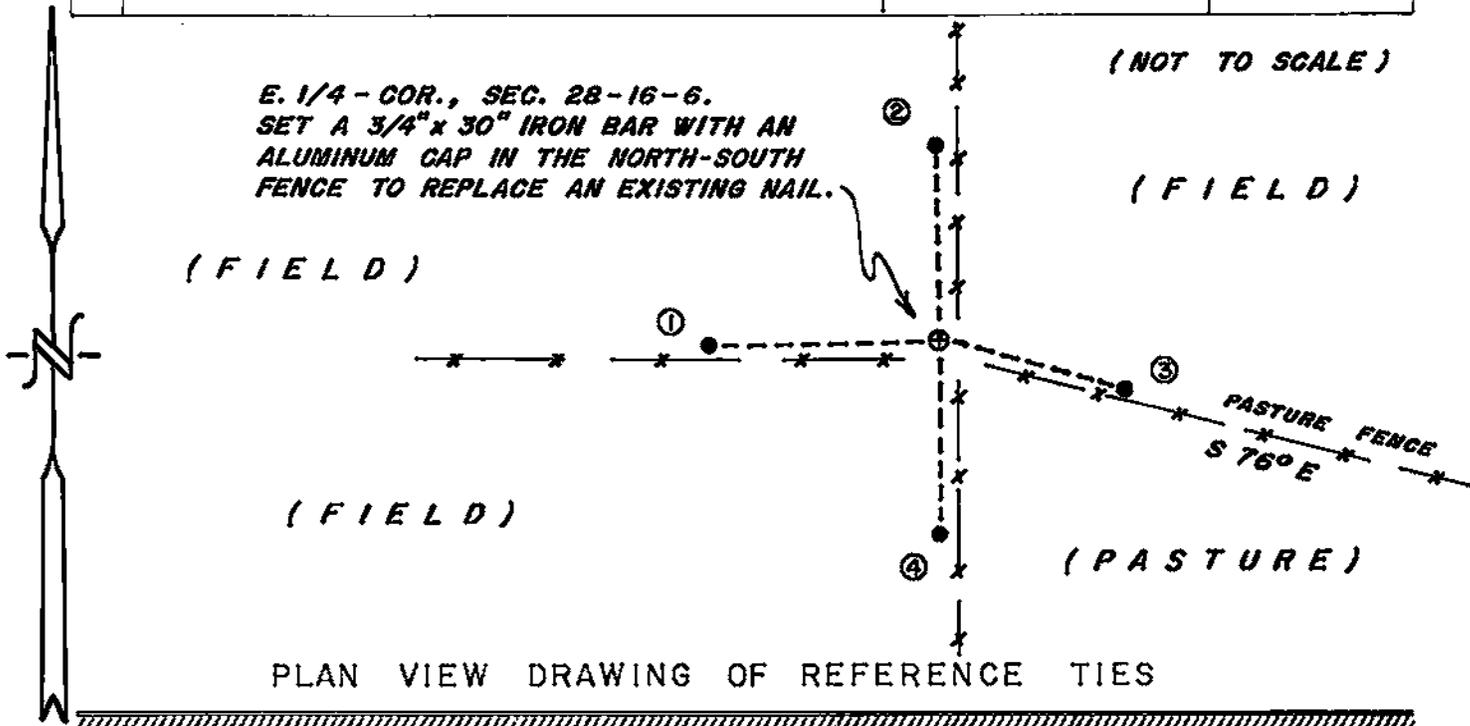

MAP SHOWING DISTANCE AND DIRECTION TO OTHER PUBLIC LAND SURVEY CORNERS USED FOR REESTABLISHING THE CORNER

No section work was done by me at this time. The location of this corner was confirmed through section measurements done by others.

I, WILLIAM C. JUNG, COUNTY SURVEYOR
 HEREBY CERTIFY THAT THE CORNER LOCATION SHOWN ON THIS RECORD WAS DETERMINED BY ME OR UNDER MY DIRECTION AND CONTROL AND THAT THIS U. S. PUBLIC LAND SURVEY MONUMENT RECORD IS CORRECT AND COMPLETE TO THE BEST OF MY KNOWLEDGE AND BELIEF.

William C. Jung 11/21/01
 Signature Date

