


U. S. PUBLIC LAND SURVEY MONUMENT RECORD

SECTION 29 T 16 N, R 6 W, TOWN OF BARRE
 LA CROSSE COUNTY

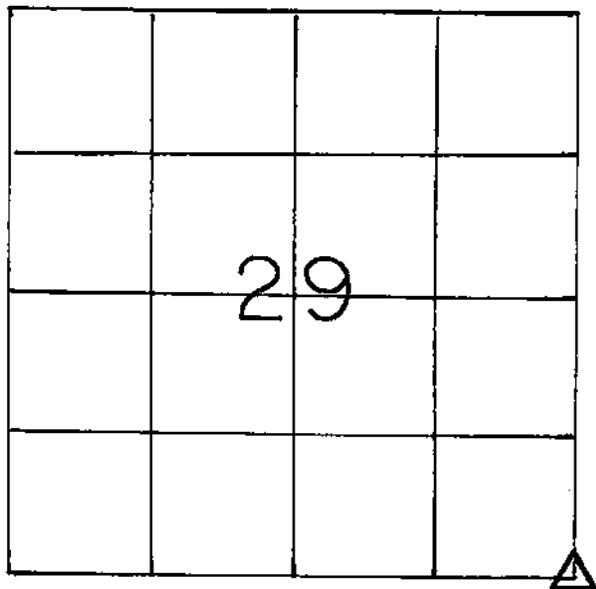

LOCATION OF LANDMARK

WISCONSIN COORDINATE SYSTEM
North
East
Theta Angle
Horiz. Order
Vert. Order
TYPE OF LANDMARK
Railroad Spike
BEARINGS ARE REFERENCED TO
Assumed

Crew: William C. Jung
 Peter F. Follansbee

Date: March 25, 1992

Describe any record evidence, monument evidence, testimonial evidence or any other material evidence you considered and whether the monument was found or restored through acceptance of an obliterated evidence location.


Last September I found a broken P.K. nail at this location and replaced it with a railroad spike. I feel that this point had been used as the corner in previous survey work. It also fits occupation. I accepted this location as the best available evidence of the original government corner position.

Describe or show any material discrepancy between the location of the restored corner and that of the corner previously restored or reestablished.

None known. W-NW of this corner at a distance of 8.73' I found a nail. I don't know its origin.


RECORD OF DURABLE WITNESS MONUMENTS

NO	DESCRIPTION	BEARING	DISTANCE
1	Set 1" iron pipe	-----	40.88
2	"	East _±	32.99
3	To the Northeast corner of a phone box	-----	35.65
4	Set a 1" iron pipe 1' East of a utility pole	-----	73.80

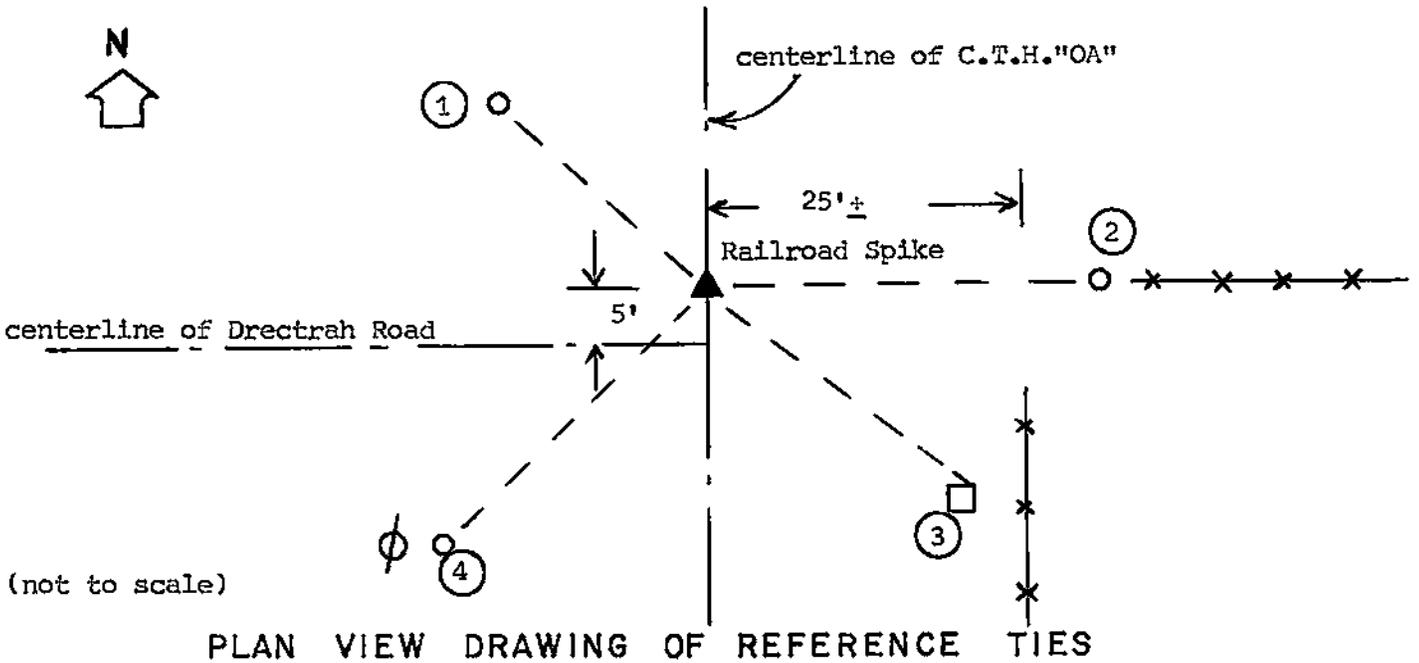


MAP SHOWING DISTANCE AND DIRECTION TO OTHER PUBLIC LAND SURVEY CORNERS USED FOR REESTABLISHING THE CORNER

(not to scale)

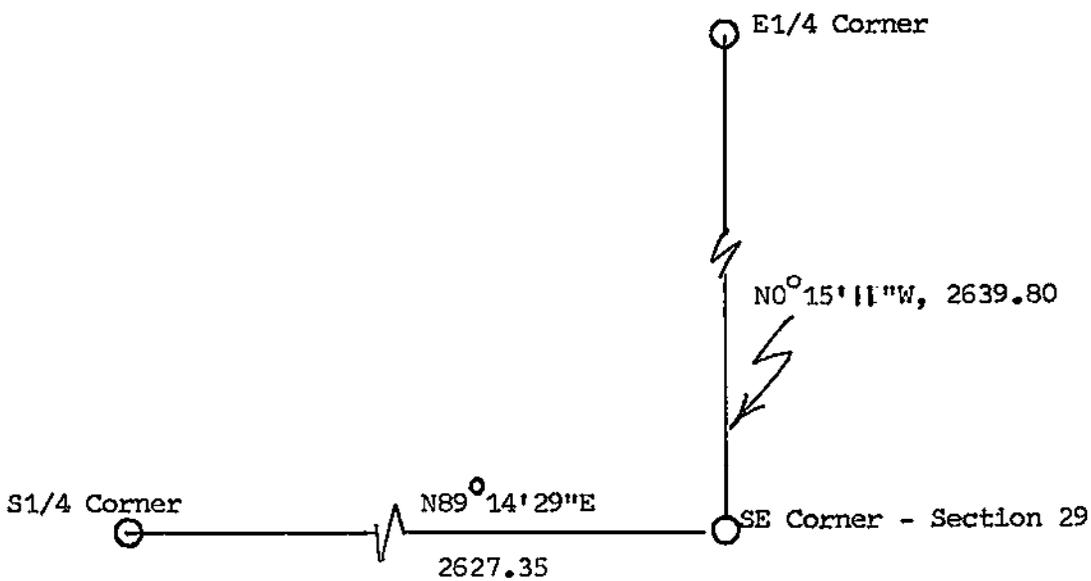

I, William C. Jung, Deputy County Surveyor,
 HEREBY CERTIFY THAT THE CORNER LOCATION SHOWN ON THIS RECORD
 WAS DETERMINED BY ME OR UNDER MY DIRECTION AND CONTROL AND
 THAT THIS U. S. PUBLIC LAND SURVEY MONUMENT RECORD IS CORRECT
 AND COMPLETE TO THE BEST OF MY KNOWLEDGE AND BELIEF.

William C. Jung May 14, 1992
 Signature Date

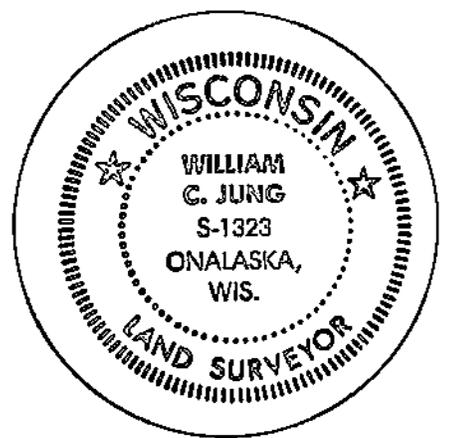

Seal