


U. S. PUBLIC LAND SURVEY MONUMENT RECORD

SECTION 29 T 16 N, R 6 W, TOWN OF BARRE
 LA CROSSE COUNTY

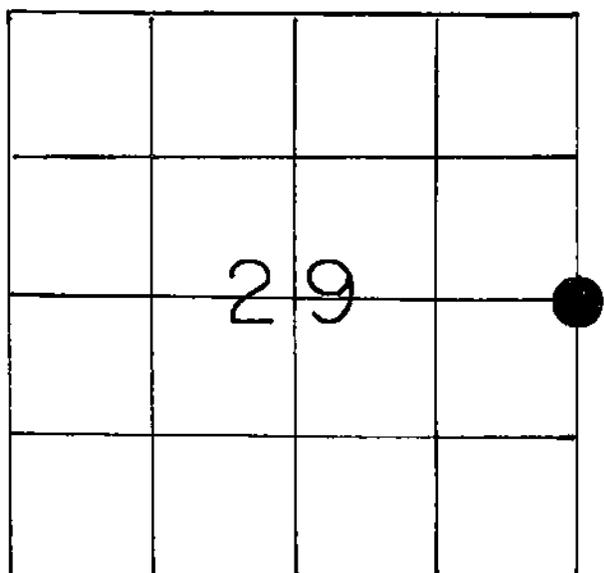

LOCATION OF LANDMARK

WISCONSIN COORDINATE SYSTEM
North
East
Theta Angle
Horiz. Order
Vert. Order
TYPE OF LANDMARK
Brass capped Lunde marker in the road
BEARINGS ARE REFERENCED TO
Assumed

Crew: William C. Jung
 Peter F. Follansbee

Dates: May 21, 1992 and 7/10/92

Describe any record evidence, monument evidence, testimonial evidence or any other material evidence you considered and whether the monument was found or restored through acceptance of an obliterated evidence location.


I set the corner on line with the section corners and on line with the old occupied East-West lines.

Describe or show any material discrepancy between the location of the restored corner and that of the corner previously restored or reestablished.

None known.


RECORD OF DURABLE WITNESS MONUMENTS

NO	DESCRIPTION	BEARING	DISTANCE
1	Southeast corner of phone box	-----	156.36
2	P.K. nail in power pole	-----	69.74
3	Railroad spike 1' South of a P.K. nail	-----	7.07
4	Set 1 1/4" iron pipe	-----	54.03

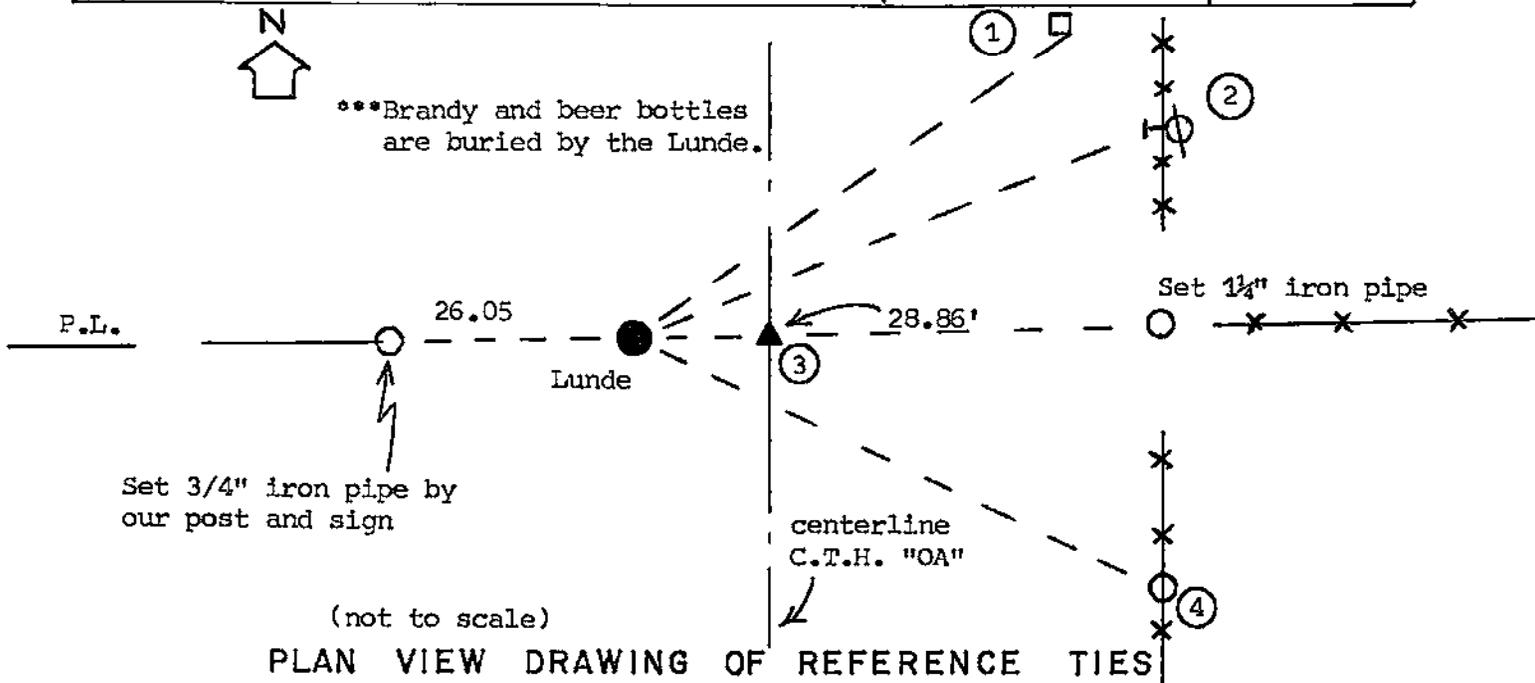

MAP SHOWING DISTANCE AND DIRECTION TO OTHER PUBLIC LAND SURVEY CORNERS USED FOR REESTABLISHING THE CORNER

(not to scale)

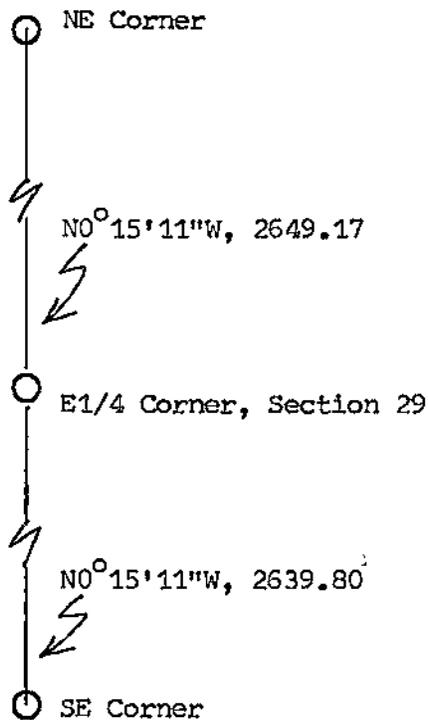


I, William C. Jung, Deputy County Surveyor,
 HEREBY CERTIFY THAT THE CORNER LOCATION SHOWN ON THIS RECORD
 WAS DETERMINED BY ME OR UNDER MY DIRECTION AND CONTROL AND
 THAT THIS U. S. PUBLIC LAND SURVEY MONUMENT RECORD IS CORRECT
 AND COMPLETE TO THE BEST OF MY KNOWLEDGE AND BELIEF.

William C. Jung
 Signature

May 29, 1992
 Date

Revised: July 10, 1992

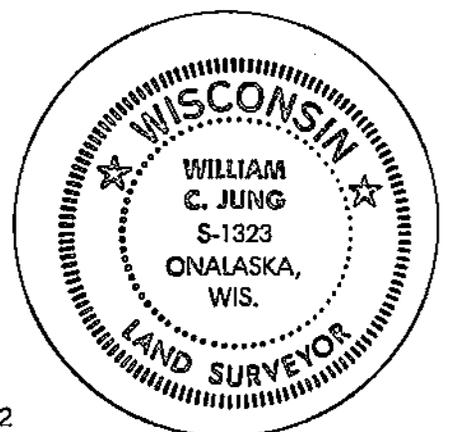

Seal