


21606300020

U. S. PUBLIC LAND SURVEY MONUMENT RECORD

SECTION 30 T 16 N, R 6 W, TOWN OF BARRE

LA CROSSE COUNTY

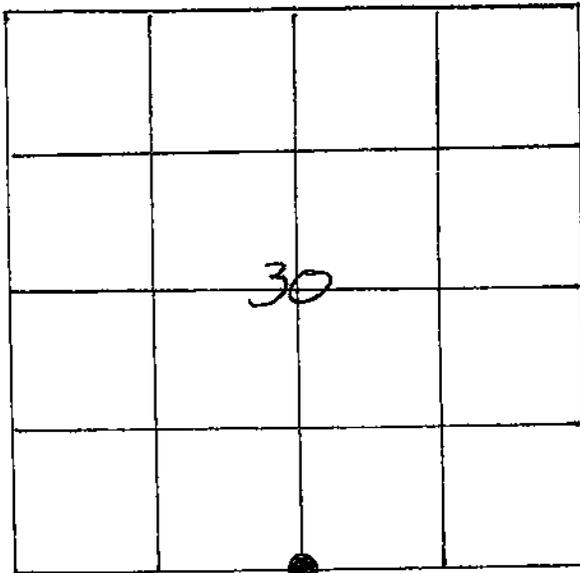

LOCATION OF LANDMARK

WISCONSIN COORDINATE SYSTEM

North

East

Theta Angle

Horiz. Order

Vert. Order

TYPE OF LANDMARK

1 1/2" IRON PIPE

BEARINGS ARE REFERENCED TO

ASSUMED (RECORDED)

Describe any record evidence, monument evidence, testimonial evidence or any other material evidence you considered and whether the monument was found or restored through acceptance of an obliterated evidence location.


I FOUND AN IRON PIPE IN AN OLD N-S FENCE NEAR A VERY OLD FENCE INTERSECTION AND ACCEPTED IT AS THE SOUTH QUARTER BASED UPON ITS PROXIMITY TO THESE OLD FENCES, AND UPON ITS FIT TO OCCUPATION TO THE NORTH.

Describe or show any material discrepancy between the location of the restored corner and that of the corner previously restored or reestablished.


NONE KNOWN

RECORD OF DURABLE WITNESS MONUMENTS

NO	DESCRIPTION	BEARING	DISTANCE
1	8" SOFT MAPLE TREE	N 24° 05' W	26.6'
2	8" CHERRY TREE	S 86° 48' E	17.3'
3	5" OAK TREE	S 47° 2' E	17.7'
4	8" HORNBEAM TREE	S 23° 10' W	27.4'

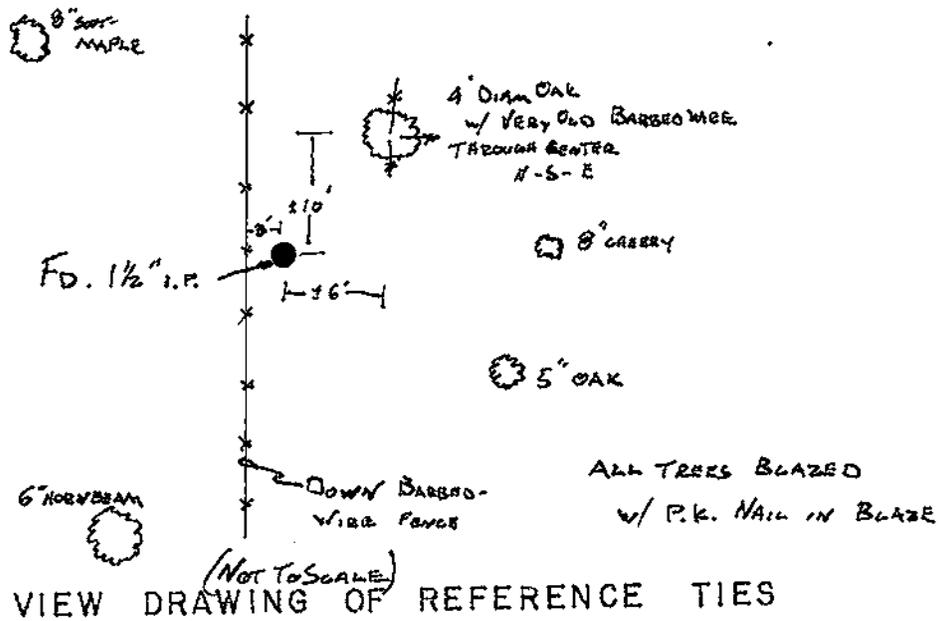

MAP SHOWING DISTANCE AND DIRECTION TO OTHER PUBLIC LAND SURVEY CORNERS USED FOR REESTABLISHING THE CORNER

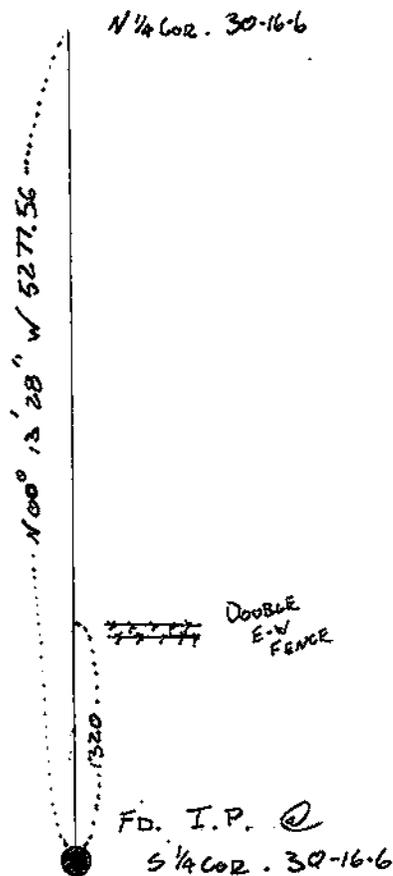

I, Paul E. Fairchild
 HEREBY CERTIFY THAT THE CORNER LOCATION SHOWN ON THIS RECORD
 WAS DETERMINED BY ME OR UNDER MY DIRECTION AND CONTROL AND
 THAT THIS U. S. PUBLIC LAND SURVEY MONUMENT RECORD IS CORRECT
 AND COMPLETE TO THE BEST OF MY KNOWLEDGE AND BELIEF.

Paul E. Fairchild
 Signature

12/9/92
 Date



Seal