


21606310000

U. S. PUBLIC LAND SURVEY MONUMENT RECORD

SECTION 31 T 16 N, R 6 W, TOWN OF BARRE

LA CROSSE COUNTY

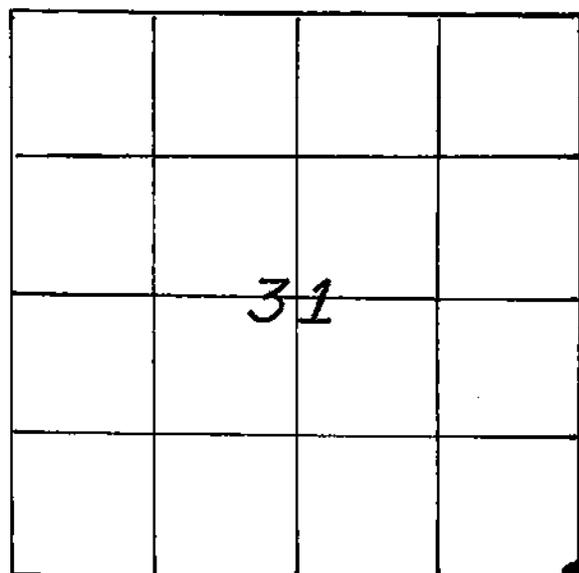

LOCATION OF LANDMARK

WISCONSIN COORDINATE SYSTEM

North

East

Theta Angle

Horiz. Order

Vert. Order

TYPE OF LANDMARK

6" X 8" SANDSTONE (Top busted up)

BEARINGS ARE REFERENCED TO

the North line of the S.E. $\frac{1}{4}$ of Section 31 ASSUMED to bear East.

CREW: Rodney Maxwell, Dwayne Hefner

DATE: 14 May, 1995

Describe any record evidence, monument evidence, testimonial evidence or any other material evidence you considered and whether the monument was found or restored through acceptance of an obliterated evidence location.

I found a 6" X 8" Sandstone although the top was busted up, the stone was very similar to the others located around this section. The stone also fit very well with the occupied fence corner. Also found large hole in ground that measured perfect for location of bearing tree. This location also fits well with other corners in Section 31. Accepted stone as best available evidence of the original government corner location.

Describe or show any material discrepancy between the location of the restored corner and that of the corner previously restored or reestablished.

None known.

