


U. S. PUBLIC LAND SURVEY MONUMENT RECORD

SECTION 31 T 16 N, R 6 W, TOWN OF BARRE  
 LA CROSSE COUNTY

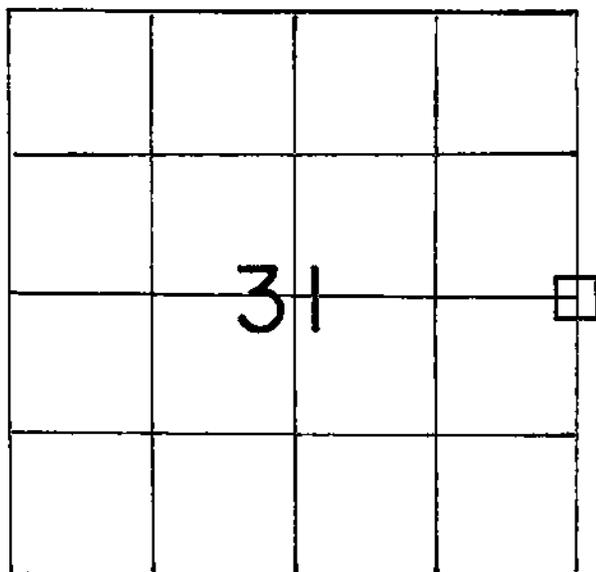

LOCATION OF LANDMARK

Crew: WILLIAM C. JUNG  
 PETER F. FOLLANSBEE

Date: 6/21/1994

Describe any record evidence, monument evidence, testimonial evidence or any other material evidence you considered and whether the monument was found or restored through acceptance of an obliterated evidence location.

I found a 5"x6" stone with a "x", up 6", at the corner. I accepted it as the best available evidence of the original government corner position.

Describe or show any material discrepancy between the location of the restored corner and that of the corner previously restored or reestablished.

None Known.

WISCONSIN COORDINATE SYSTEM
North
East
Theta Angle
Horiz. Order
Vert. Order
TYPE OF LANDMARK
Existing 5" x 6" Stone w/ "X" in top.
BEARINGS ARE REFERENCED TO

RECORD OF DURABLE WITNESS MONUMENTS  
MAGNETIC

NO	DESCRIPTION	BEARING	DISTANCE
1	Set P.K. Nail in SE-side 17" White Oak	N 35° E	17.97 Ft.
2	Set P.K. Nail in NW-side 17" White Oak	N 65° E	10.76 Ft.
3	Set P.K. Nail in NE-side 15" White Oak	S 30° E	31.47 Ft.
4	Set P.K. Nail in E.-side 8" Hickory	S 17° W	28.00 Ft.

(Note: all B.T.'s are single blazed)

E. 1/4-Cor., Sec. 31-16-6.  
Existing 5" x 6" Stone with an  
"X" in the top. The Stone sits  
up about 6 inches.

Nailed a sign to  
this White Oak.

( Not to scale )


PLAN VIEW DRAWING OF REFERENCE TIES

MAP SHOWING DISTANCE AND DIRECTION TO OTHER PUBLIC LAND SURVEY CORNERS USED FOR REESTABLISHING THE CORNER

No section measurements were made by me at this time. The location of this stone was confirmed by previous survey work.

I, William C. Jung, County Surveyor  
HEREBY CERTIFY THAT THE CORNER LOCATION SHOWN ON THIS RECORD  
WAS DETERMINED BY ME OR UNDER MY DIRECTION AND CONTROL AND  
THAT THIS U. S. PUBLIC LAND SURVEY MONUMENT RECORD IS CORRECT  
AND COMPLETE TO THE BEST OF MY KNOWLEDGE AND BELIEF.

William C. Jung                      9/23/94  
Signature                                      Date

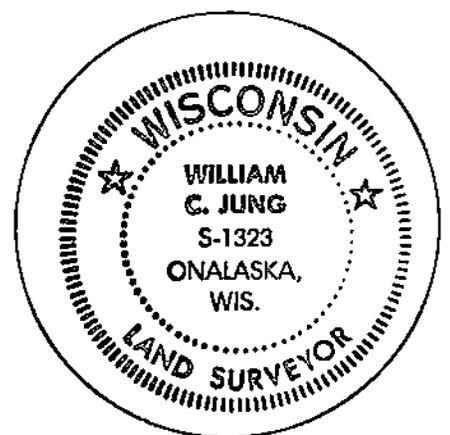

Seal