


21606322000

U. S. PUBLIC LAND SURVEY MONUMENT RECORD

SECTION 32 T 16 N, R 6 W, TOWN OF BARRE

LA CROSSE COUNTY

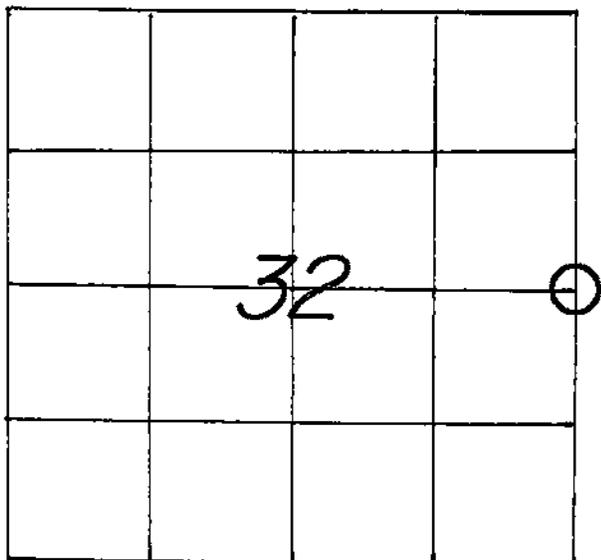

WISCONSIN COORDINATE SYSTEM	
North	665,169.954
East	1,675,332.508
Theta Angle	
Horiz. Order	
Vert. Order	
DATUM:	1983('91)
TYPE OF LANDMARK	
2" O.D. x 49" IRON PIPE.	
BEARINGS ARE REFERENCED TO	
GRID NORTH AS PER SECTION DATA.	

LOCATION OF LANDMARK

CREW: WILLIAM C. JUNG
 PETER F. FOLLANSBEE
 DATE: 9/30/2008

Describe any record evidence, monument evidence, testimonial evidence or any other material evidence you considered and whether the monument was found or restored through acceptance of an obliterated evidence location.

This corner being lost, I set it by single proportionate measurement. I set a 2" iron pipe at the corner. I could not find a stone.

Describe or show any material discrepancy between the location of the restored corner and that of the corner previously restored or reestablished.

NONE KNOWN.

