


21606330000

U. S. PUBLIC LAND SURVEY MONUMENT RECORD

SECTION 34 T 16 N, R 6 W, TOWN OF Barre

LA CROSSE COUNTY

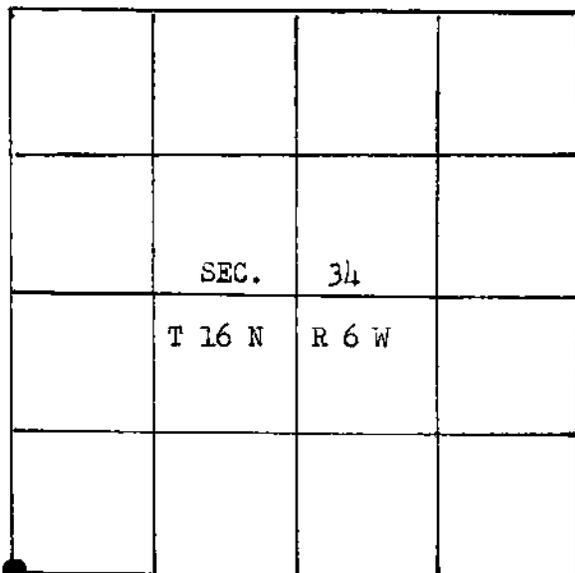

LOCATION OF LANDMARK

WISCONSIN COORDINATE SYSTEM

North

East

Theta Angle

Horiz. Order

Vert. Order

TYPE OF LANDMARK

2" X 30" IRON PIPE

BEARINGS ARE REFERENCED TO the West line of Sec. 34, T 16 N, R 6 W, Assumed Bearing $N0^{\circ}58'16''W$.

Describe any record evidence, monument evidence, testimonial evidence or any other material evidence you considered and whether the monument was found or restored through acceptance of an obliterated evidence location.


The SW corner of Section 34 was re-established by acceptance of occupational evidence together with extensive survey information gathered throughout Section 34 to assist in verifying this corner.

Describe or show any material discrepancy between the location of the restored corner and that of the corner previously restored or reestablished.

N/A

SW CORNER OF SECTION 34, T 16 N, R 6W, TOWN OF BARRE, LACROSSE CO.
 RECORD OF DURABLE WITNESS MONUMENTS


NO	DESCRIPTION	BEARING	DISTANCE
1	10" DIAM. COTTON WOOD, P.K. NAIL SET AT BASE AND ON SOUTH SIDE OF TREE.	N30°E	22.25 feet
2	8" DIAM. WHITE OAK, P.K. NAIL SET AT BASE AND ON SOUTH SIDE OF TREE.	EAST	0.85 feet
3	8" DIAM. DOUBLE ELM, P.K. NAIL 4'± ABOVE GROUND AND ON NE SIDE OF TREE.	N50°W	13.65 feet
4	10" DIAM. BIRCH, P.K. NAIL SET AT BASE AND ON SE SIDE OF TREE.	N02°W	21.03 feet

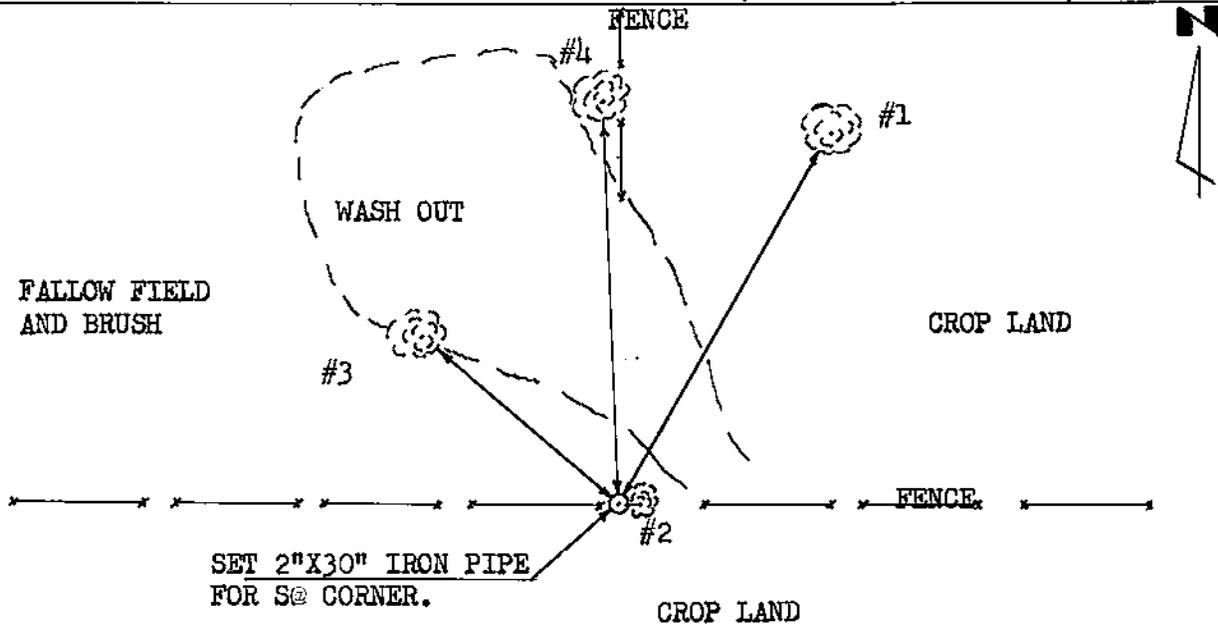

PLAN VIEW DRAWING OF REFERENCE TIES

MAP SHOWING DISTANCE AND DIRECTION TO OTHER PUBLIC LAND SURVEY CORNERS USED FOR REESTABLISHING THE CORNER

NW CORNER
 SECTION 34
 T16N R6W
 2"X30" I.P.

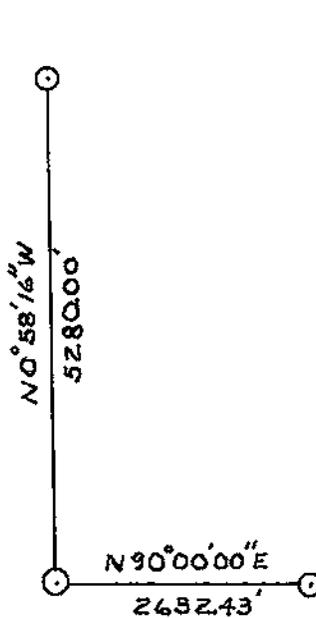

SW CORNER
 SECTION 34
 T16N R6W
 2"X30" I.P.

1/4 CORNER
 SECTION 34
 T16N R6W
 2"X30" I.P.

I, Robert M. Lampman, Registered Land Surveyor, do
 HEREBY CERTIFY THAT THE CORNER LOCATION SHOWN ON THIS RECORD
 WAS DETERMINED BY ME OR UNDER MY DIRECTION AND CONTROL AND
 THAT THIS U. S. PUBLIC LAND SURVEY MONUMENT RECORD IS CORRECT
 AND COMPLETE TO THE BEST OF MY KNOWLEDGE AND BELIEF.

Robert M. Lampman March 12, 1984
 Signature Date



Seal