


U. S. PUBLIC LAND SURVEY MONUMENT RECORD

SECTION 33 T 16 N, R 6 W, TOWN OF BARRE / GREENFIELD
 LA CROSSE COUNTY

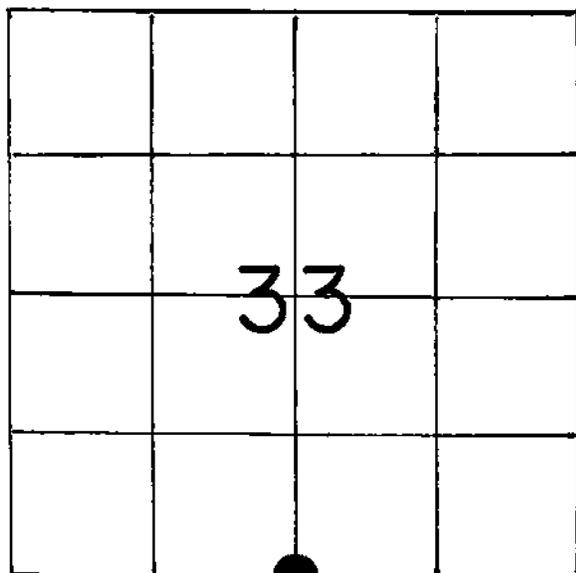

LOCATION OF LANDMARK

| |
|---------------------------------------|
| WISCONSIN COORDINATE SYSTEM |
| North |
| East |
| Theta Angle |
| Horiz. Order |
| Vert. Order |
| TYPE OF LANDMARK |
| Set 1/2" x 26" Rebar in broken Stone. |
| BEARINGS ARE REFERENCED TO |

Crew: WILLIAM C. JUNG
 PETER F. FOLLANSBEE

Date: 6/22/1994

Describe any record evidence, monument evidence, testimonial evidence or any other material evidence you considered and whether the monument was found or restored through acceptance of an obliterated evidence location.

I found remnants of an old corner stone which I accepted as the best available evidence of the original government corner position. I set a 1/2"x26" rebar in the middle of the broken stone fragments. About N78°W, 13.86 feet from the stone, I found a railroad spike which I assume that Steve Solberg put in. It appears to be a survey point only.

Describe or show any material discrepancy between the location of the restored corner and that of the corner previously restored or reestablished.

None Known.

