


21606332000

U. S. PUBLIC LAND SURVEY MONUMENT RECORD

SECTION 34 T 16 N, R 6 W, TOWN OF BARRE

LA CROSSE COUNTY

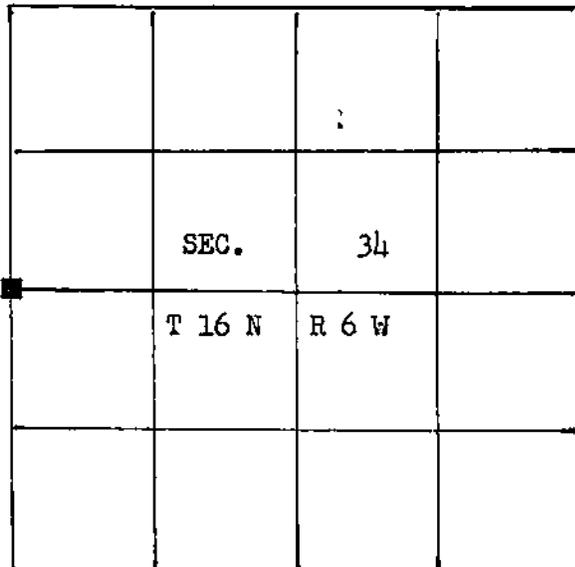

LOCATION OF LANDMARK

WISCONSIN COORDINATE SYSTEM

North
East
Theta Angle
Horiz. Order
Vert. Order

TYPE OF LANDMARK
W 1/4 COR. 2" X 30" IRON PIPE

BEARINGS ARE REFERENCED TO THE WEST LINE OF SECTION 34, T16N, R6W, ASSUMED BEARING NO 58'16"W.

Describe any record evidence, monument evidence, testimonial evidence or any other material evidence you considered and whether the monument was found or restored through acceptance of an obliterated evidence location.

The W 1/4 corner of Section 34 restored at equal distance and on line between the NW corner and the SW corner of Section 34 together with extensive survey information gathered throughout Section 34 to assist in verifying this corner location.

Describe or show any material discrepancy between the location of the restored corner and that of the corner previously restored or reestablished.

