

U. S. PUBLIC LAND SURVEY MONUMENT RECORD

SECTION 34 T 16 N, R 6 W, TOWN OF BARRE

LA CROSSE COUNTY

	SEC.	34	
	T 16 N	R 6 W	

LOCATION OF LANDMARK

WISCONSIN COORDINATE SYSTEM
North
East
Theta Angle
Horiz. Order
Vert. Order
TYPE OF LANDMARK
E 1/4 CORNER, 2" X 30" IRON PIPE
BEARINGS ARE REFERENCED TO THE WEST LINE OF SECTION 34, T16N, R6W, ASSUMED BEARING N0°58'16"W.

Describe any record evidence, monument evidence, testimonial evidence or any other material evidence you considered and whether the monument was found or restored through acceptance of an obliterated evidence location.


The E 1/4 corner of Section 34 was re-set through acceptance of the found remains of a cut sand stone, occupational evidence together with extensive survey information gathered throughout Section 34 to assist in verifying this corner location.

Describe or show any material discrepancy between the location of the restored corner and that of the corner previously restored or reestablished.

N/A


E 1/4 CORNER OF SECTION 34, T 16 N, R 6 W, TOWN OF BARRE, LACROSSE CO.
 RECORD OF DURABLE WITNESS MONUMENTS

NO	DESCRIPTION	BEARING	DISTANCE
1	18" BLACK OAK, SET SPIKE AT BASE AND ON THE WEST SIDE OF TREE.	N 05° E	3.82 FEET
2	16" BLACK OAK, SET SPIKE AT BASE AND ON THE SOUTH SIDE OF TREE.	EAST	3.96 FEET
3	10" HICKORY, SET SPIKE 6± ABOVE GROUND AND ON THE SOUTH SIDE OF TREE.	EAST	22.50 FEET
4	DOUBLE BIRCH, SET SPIKE 4± ABOVE GROUND AND ON THE EAST SIDE OF TREE.	N 20° W	27.80 FEET

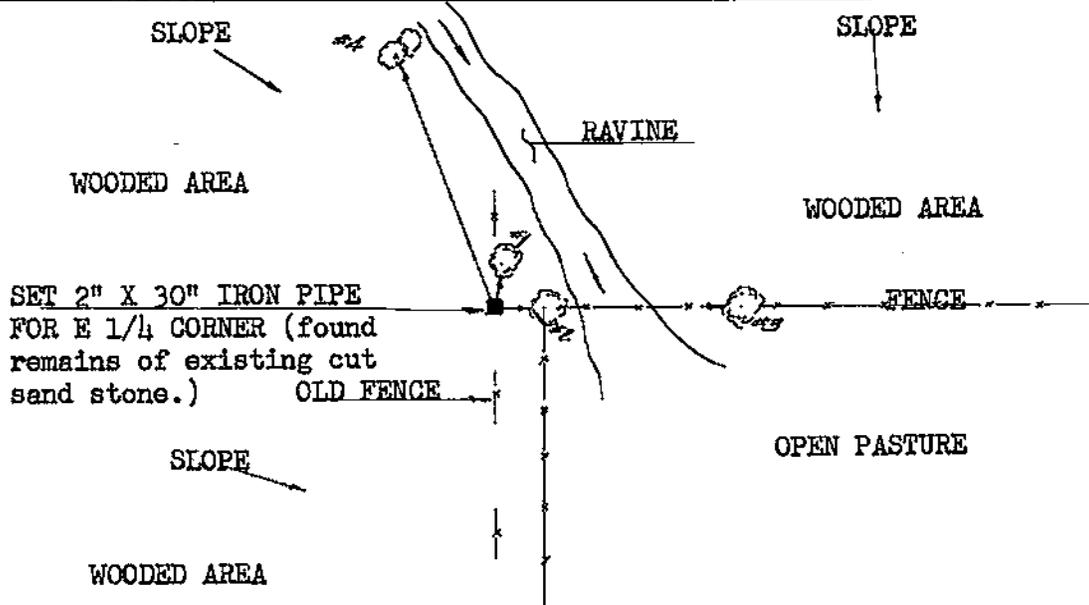


PLAN VIEW DRAWING OF REFERENCE TIES

MAP SHOWING DISTANCE AND DIRECTION TO OTHER PUBLIC LAND SURVEY CORNERS USED FOR REESTABLISHING THE CORNER

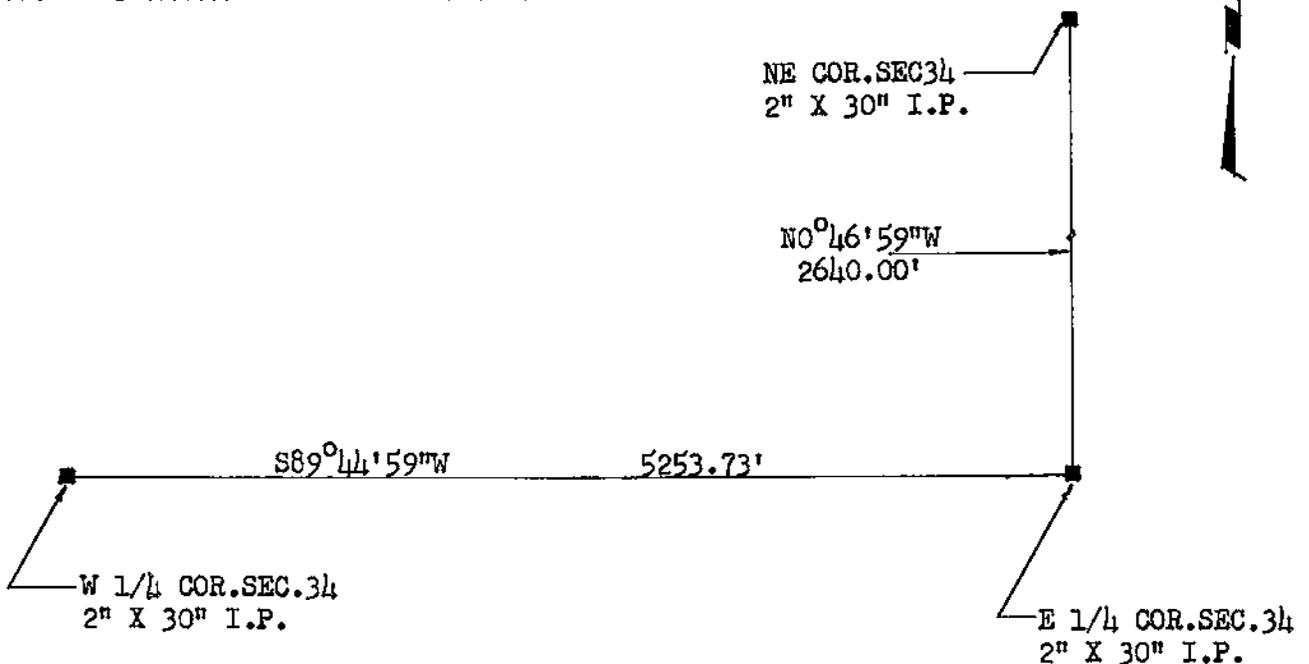

I, Robert M. Lampman, Registered Land Surveyor, do
 HEREBY CERTIFY THAT THE CORNER LOCATION SHOWN ON THIS RECORD
 WAS DETERMINED BY ME OR UNDER MY DIRECTION AND CONTROL AND
 THAT THIS U. S. PUBLIC LAND SURVEY MONUMENT RECORD IS CORRECT
 AND COMPLETE TO THE BEST OF MY KNOWLEDGE AND BELIEF.

Robert M. Lampman March 12, 1984
 Signature Date

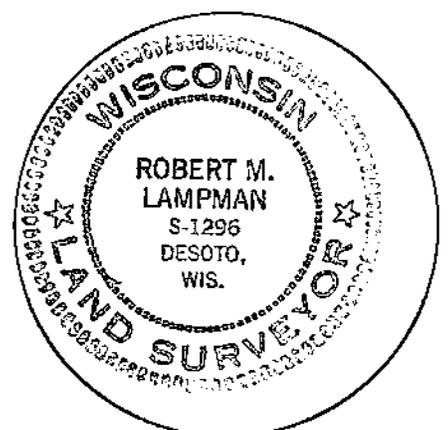

Seal