


U. S. PUBLIC LAND SURVEY MONUMENT RECORD

SECTION 35 T 16 N, R 6 W, TOWN OF BARRE

LA CROSSE COUNTY

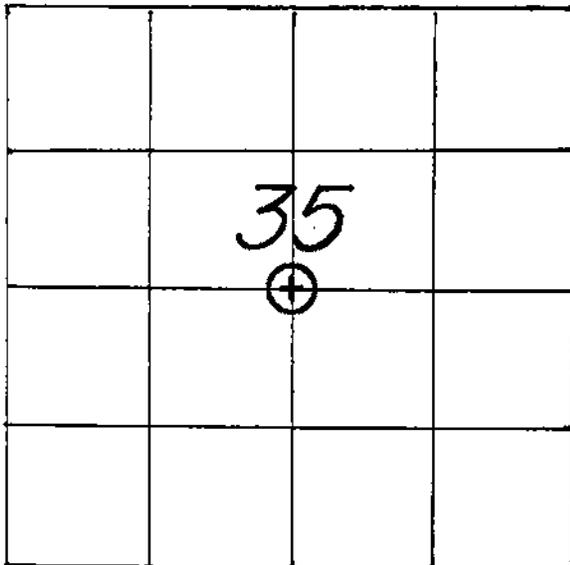

LOCATION OF LANDMARK

CREW: **WILLIAM C. JUNG**
PETER F. FOLLANSBEE
 DATE: **7/16/2008**

WISCONSIN COORDINATE SYSTEM

North

East

Theta Angle

Horiz. Order

Vert. Order

TYPE OF LANDMARK

3/4" x 30" IRON BAR WITH ALUMINUM CAP.

BEARINGS ARE REFERENCED TO

Describe any record evidence, monument evidence, testimonial evidence or any other material evidence you considered and whether the monument was found or restored through acceptance of an obliterated evidence location.

I had previously completed section work in and around Section 35. Norm Hurlburt then did more interior work in Section 35. After analyzing the section data and evidence, Norm and I agreed that the Center 1/4 Corner had been set in an irregular method some time ago. Therefore, we decided and agreed that the corner should be reset again by this irregular method. This method is consistent with Wisconsin surveying law and history. I replaced Hurlburt's nail with an iron bar and cap. Describe or show any material discrepancy between the location of the restored corner and that of the corner previously restored or reestablished.

NONE KNOWN.

