


21606362000

U. S. PUBLIC LAND SURVEY MONUMENT RECORD

SECTION 36 T 16 N, R 6 W, TOWN OF BARRE

LA CROSSE COUNTY

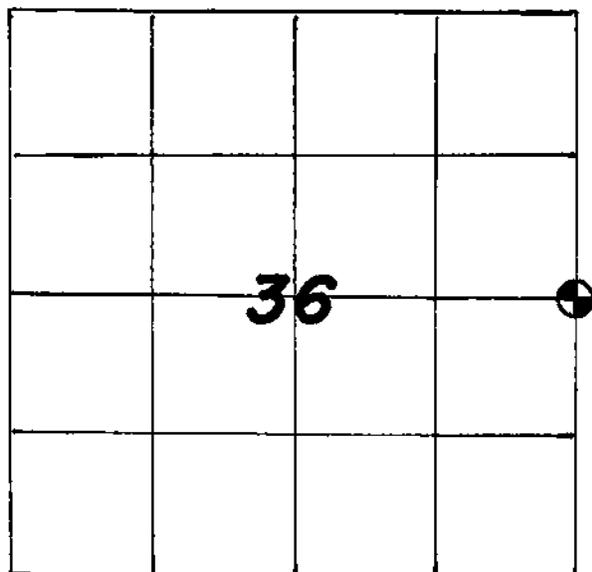

WISCONSIN COORDINATE SYSTEM

North

East

Theta Angle

Horiz. Order

Vert. Order

TYPE OF LANDMARK

LUNDE MARKER

BEARINGS ARE REFERENCED TO

LOCATION OF LANDMARK

CREW: BILL JUNG, PERRY DAHL

DATE: 5-19-87

Describe any record evidence, monument evidence, testimonial evidence or any other material evidence you considered and whether the monument was found or restored through acceptance of an obliterated evidence location.


I found a broken stone at the corner and accepted it as the best available evidence of the original government corner position. I replaced the broken stone with a Lunde marker and placed pieces of broken stone around the Lunde marker. The marker is set flush.

Describe or show any material discrepancy between the location of the restored corner and that of the corner previously restored or reestablished.

None known.

RECORD OF DURABLE WITNESS MONUMENTS

NO	DESCRIPTION	BEARING	DISTANCE
1	P.K. NAIL IN DOUBLE-BLAZED BLACK OAK, 12"	---	20.94'
2	P.K. NAIL IN DOUBLE-BLAZED WHITE OAK, 5"	---	5.70'
3	P.K. NAIL IN DOUBLE-BLAZED WHITE OAK, 14"	---	24.83'
4	P.K. NAIL IN DOUBLE-BLAZED WHITE OAK, 11"	---	18.30'

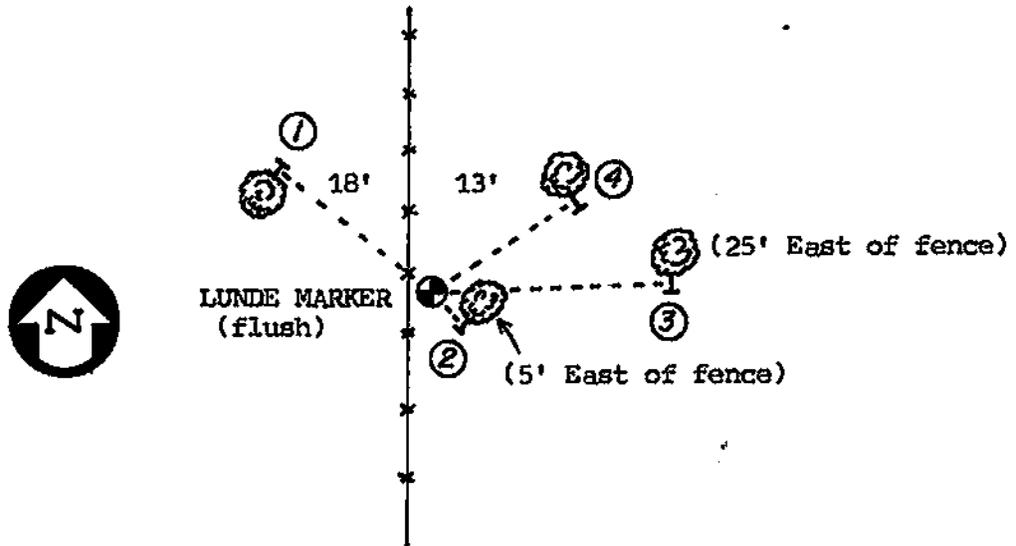

PLAN VIEW DRAWING OF REFERENCE TIES

MAP SHOWING DISTANCE AND DIRECTION TO OTHER PUBLIC LAND SURVEY CORNERS USED FOR REESTABLISHING THE CORNER

(no measurements made by me at this time)

I, William C. Jung, Deputy County Surveyor,
 HEREBY CERTIFY THAT THE CORNER LOCATION SHOWN ON THIS RECORD
 WAS DETERMINED BY ME OR UNDER MY DIRECTION AND CONTROL AND
 THAT THIS U. S. PUBLIC LAND SURVEY MONUMENT RECORD IS CORRECT
 AND COMPLETE TO THE BEST OF MY KNOWLEDGE AND BELIEF.

William C. Jung
 Signature

July 16, 1987
 Date



Seal