


21607130000

## U. S. PUBLIC LAND SURVEY MONUMENT RECORD

SECTION 19 T 16 N, R 6 W, TOWN OF BARRE

LA CROSSE COUNTY

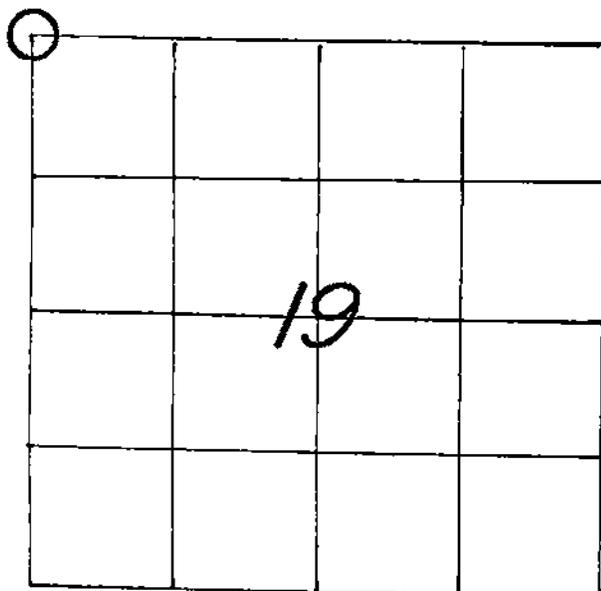

LOCATION OF LANDMARK

CREW: **WILLIAM C. JUNG**  
**PETER F. FOLLANSBEE**  
 DATE: **5/23/2006**

WISCONSIN COORDINATE SYSTEM	
North	678,376.754
East	1,665,291.120
Theta Angle	
Horiz. Order	
Vert. Order	
DATUM:	1983('91)
TYPE OF LANDMARK	
2" (O.D.) x 49" IRON PIPE.	
BEARINGS ARE REFERENCED TO	
GRID NORTH AS PER SECTION DATA.	

Describe any record evidence, monument evidence, testimonial evidence or any other material evidence you considered and whether the monument was found or restored through acceptance of an obliterated evidence location.


I set an iron pipe at K. Don Pederson's computed location. This falls in the old North-South fence. There were four original bearing trees of record. I found no evidence of these trees. I did not accept the rebar that I found to the South. I searched at length for a stone but could not find one.

Describe or show any material discrepancy between the location of the restored corner and that of the corner previously restored or reestablished.


This does not agree with Bob Chalsma's section corner location.

RECORD OF DURABLE WITNESS MONUMENTS

NO	DESCRIPTION	GRID BEARINGS	
		BEARING	DISTANCE
1	SET A NAIL IN N.W.-SIDE OF A DOUBLE WILLOW	N 25°44'31"E	139.09 FT.
2	SET A NAIL IN W.-SIDE OF A 9-1/2" WILLOW	N 81°39'55"E	91.98 FT.
3	EXISTING REBAR IN THE FENCELINE	S 00°59'55"W	11.08 FT.
4	SET A NAIL IN W.-SIDE OF A 20" COTTONWOOD	S 03°47'49"W	65.50 FT.

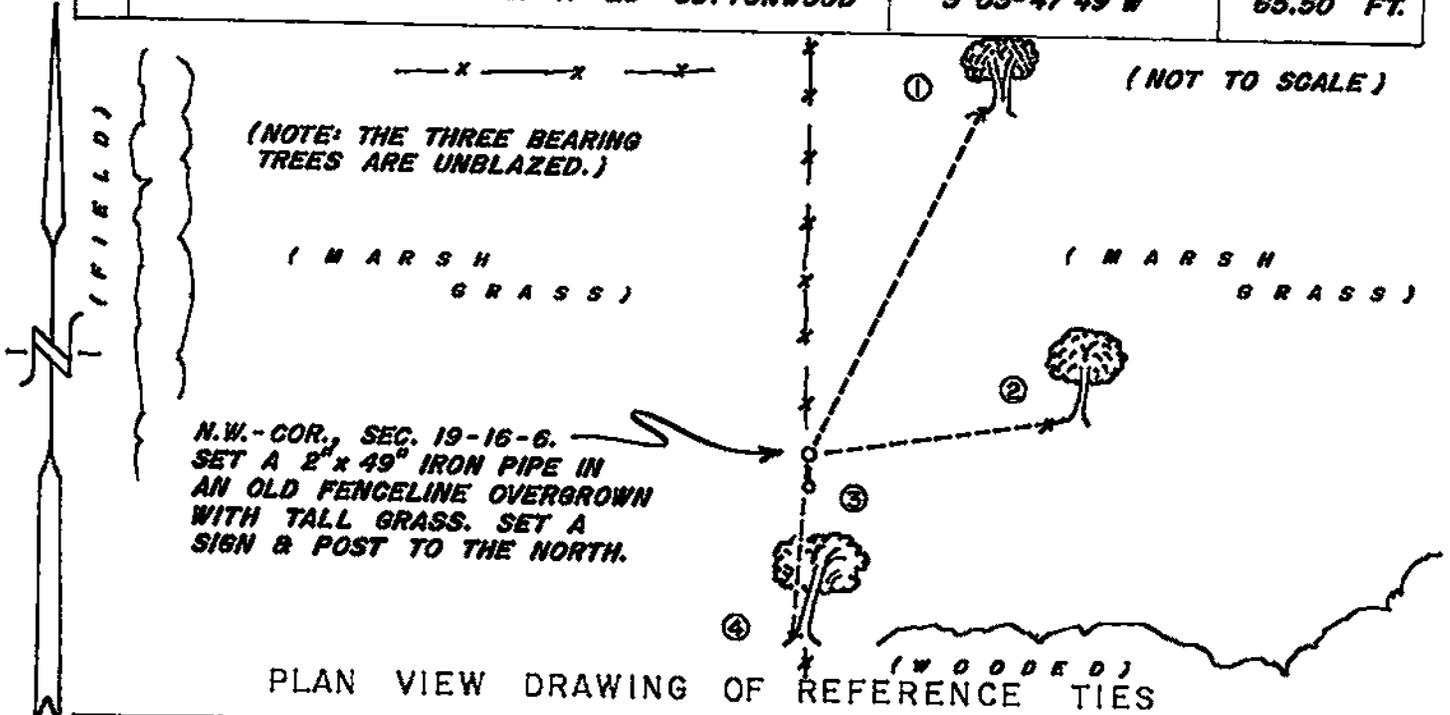


MAP SHOWING DISTANCE AND DIRECTION TO OTHER PUBLIC LAND SURVEY CORNERS USED FOR REESTABLISHING THE CORNER

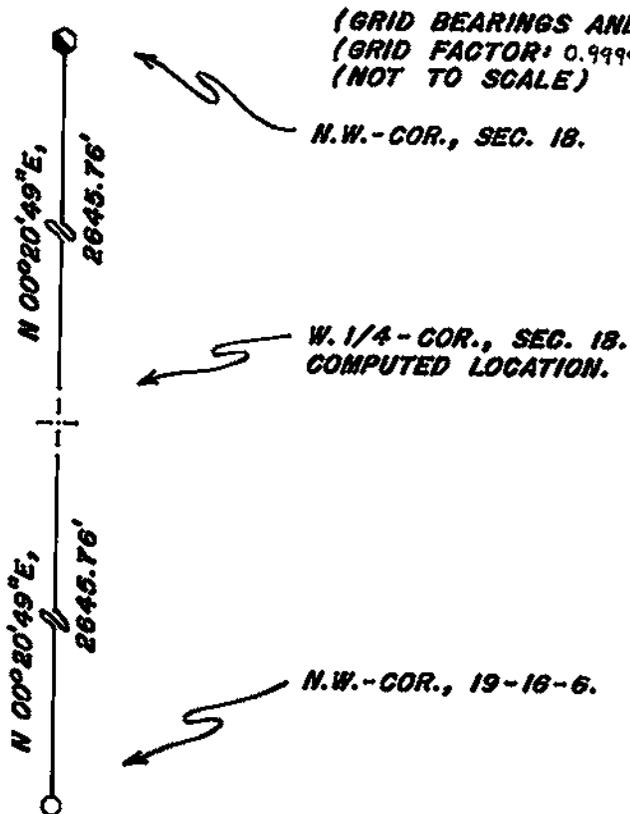

I, WILLIAM C. JUNG, COUNTY SURVEYOR  
 HEREBY CERTIFY THAT THE CORNER LOCATION SHOWN ON THIS RECORD  
 WAS DETERMINED BY ME OR UNDER MY DIRECTION AND CONTROL AND  
 THAT THIS U. S. PUBLIC LAND SURVEY MONUMENT RECORD IS CORRECT  
 AND COMPLETE TO THE BEST OF MY KNOWLEDGE AND BELIEF.

*William C. Jung*  
 Signature

7/7/06  
 Date

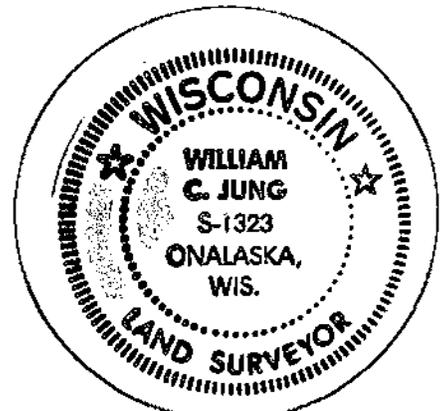

Seal