


21607362000

U. S. PUBLIC LAND SURVEY MONUMENT RECORD

SECTION 31 T 16 N, R 6 W, TOWN OF BARRE

LA CROSSE COUNTY

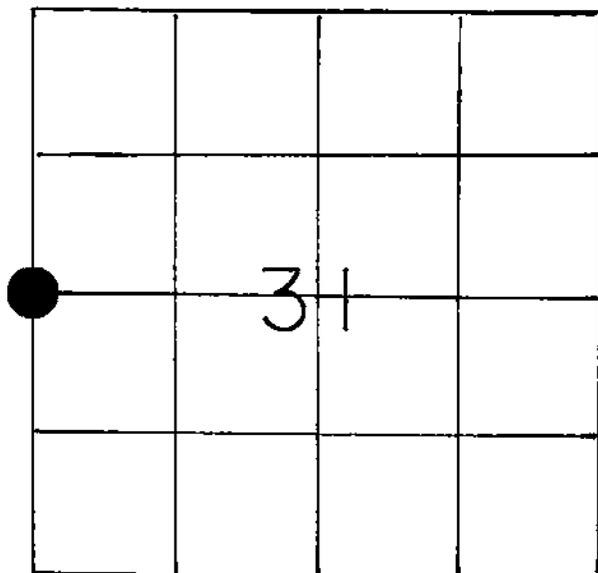

LOCATION OF LANDMARK

CREW: WILLIAM C. JUNG
PETER F. FOLLANSBEE

09/18/1987

Describe any record evidence, monument evidence, testimonial evidence or any other material evidence you considered and whether the monument was found or restored through acceptance of an obliterated evidence location.

I found a stone at the corner which I accepted as the best available evidence of the original government corner position.

Describe or show any material discrepancy between the location of the restored corner and that of the corner previously restored or reestablished.

NONE KNOWN

WISCONSIN COORDINATE SYSTEM

North

East

Theta Angle

Horiz. Order

Vert. Order


TYPE OF LANDMARK

FD. 6"SQ. STONE, UP 18"±, CHSLD. 1/4S, w/"x"

BEARINGS ARE REFERENCED TO

RECORD OF DURABLE WITNESS MONUMENTS

NO	DESCRIPTION	MAGNETIC	
		BEARING	DISTANCE
1	P.K. NAIL IN 21" BLACK OAK (DOUBLE BLAZED)	S 58 W	142.76 FT.
2	P.K. NAIL IN 21" WHITE OAK (DOUBLE BLAZED)	S 32 W	113.18 FT.
3	P.K. NAIL IN 23" WHITE OAK (DOUBLE BLAZED)	S 16 E	98.87 FT.
4	P.K. NAIL IN 19" HICKORY (DOUBLE BLAZED)	S 74 E	4.43 FT.

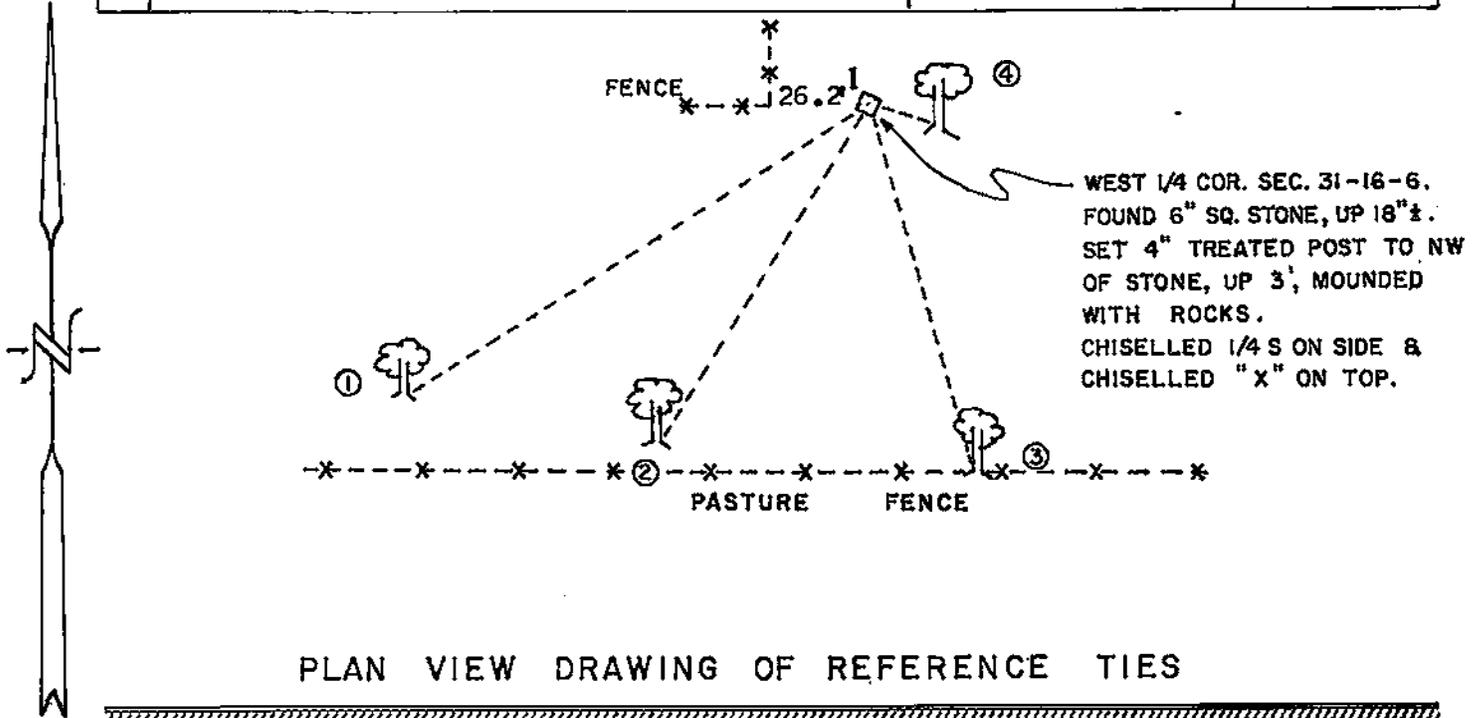

PLAN VIEW DRAWING OF REFERENCE TIES

MAP SHOWING DISTANCE AND DIRECTION TO OTHER PUBLIC LAND SURVEY CORNERS USED FOR REESTABLISHING THE CORNER

(no measurements made by me at this time)

I, WILLIAM C. JUNG
 HEREBY CERTIFY THAT THE CORNER LOCATION SHOWN ON THIS RECORD
 WAS DETERMINED BY ME OR UNDER MY DIRECTION AND CONTROL AND
 THAT THIS U. S. PUBLIC LAND SURVEY MONUMENT RECORD IS CORRECT
 AND COMPLETE TO THE BEST OF MY KNOWLEDGE AND BELIEF.

William C. Jung Deputy County Surveyor, December 11, 1987
 Signature Date



Seal